

# OREGON CORNER RESTORATION FORM

COUNTY: Umatilla. DATE: 04/27/17.

CORNER DESIGNATION: J-3, The South one-quarter corner of Section 7, Township 2 North, Range 28 East, W.M..

PREVIOUS RENEWALS/SURVEYS ETC: Corner originally established by David P. Thompson Contract No. 83 dated July 22, 1859. Notes state: Set post corner for 1/4 Sec. corner in mound of earth & as per instructions. The corner was reestablished by John Kimbrell, Deputy County Surveyor, in Survey No. 357, recorded at Record of Private Survey Book 2, Page 216, in December 1912. Kimbrell reports setting a marked square wood post 18" in the ground at the corner point.

MONUMENT AND ACCESSORIES FOUND: None. Corner was reestablished by single proportionate measurement between the reestablished Southeast corner of Section 7 and computed position for the Southwest corner of said Section 7. Broken glass and pottery fragments were found in the corner area in the active wheat field.

### MONUMENT MARKING DETAIL:

T2N R28E  
S7  
1/4 -----  
S18  
2017  
PLS 1106

MONUMENT SET: At the reestablished corner position, set a 1 1/4" by 30" galv. iron pipe with 2 3/8" brass cap 29" in the ground and surrounded by three rocks. Cap is marked as shown in Monument Marking Detail.

### New accessories:

- A 5/8" by 24" rebar with 1 1/4" red plastic cap bears N 65° E, 75.9 feet.
- A 5/8" by 24" rebar with 1 1/4" red plastic cap bears S 89° E, 64.9 feet.
- A 5/8" by 24" rebar with 1 1/4" red plastic cap bears S 58° E, 73.1 feet.
- An orange "Deep 1" magnet bears N 31° W, 20.3 feet.

The red plastic caps are marked "ORPLS 1106 WAPLS 17372". All rebar accessories are set near the East edge of the active wheat field with "bearing object" signs wired to the rebars. The "Deep 1" magnet is set 20" in the ground with "bearing object" sign placed just above it. Set steel fence post 1 1/2 feet South of corner monument with "witness" sign wired to it.

LOCATION AND COMMENTS: Corner is located at in an active wheat field 65 feet West of the East edge of the field.

FIRM: Wells Surveying  
P.O. Box 1696  
Pendleton, OR 97801


COMPASS DECLINATION: 18° East

Surveyor's Seal

\2N28J3



*Will. R. Wells*

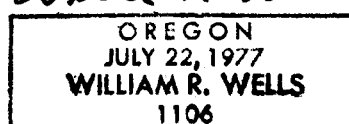

*renews 6-30-18*