

OREGON CORNER RESTORATION FORM

COUNTY: Umatilla. DATE: 04/22/17.

CORNER DESIGNATION: N-1, The Southwest corner of Section 18, Township 2 North, Range 28 East, W.M..

PREVIOUS RENEWALS/SURVEYS ETC: Corner originally established by David P. Thompson Contract No. 83 dated July 22, 1859. Notes state: Set post for corner to Secs. 18, 19, 13 & 24 in mound of earth & as per instructions. The corner point was recovered by John Kimbrell, Deputy County Surveyor, in Survey No. 357, recorded at Record of Private Survey Book 2, Page 216, in December, 1912. Kimbrell reports setting a marked, square post 18" in the ground for the corner point. In Survey No. L-42-A, Dave Krumbein reports finding and tying a fence intersection, which he held for the section corner.

MONUMENT AND ACCESSORIES FOUND: The fence intersection reported on Krumbein Survey No. L-42-A has been removed and farmed over. I computed the position of the fence intersection tied by Krumbein from ties to his Survey No. L-42-A and held the reestablished fence intersection position as best remaining evidence of the original section corner location.

MONUMENT MARKING DETAIL:

T2N
R27E R28E
S13 | S18

S24 | S19
2017
PLS 1106

MONUMENT SET: At the reestablished corner point, set a 1 1/4" by 30" galv. iron pipe with 2 3/8" brass cap 42" in the ground. Cap is marked as shown in "Monument Marking Detail". I found rotted fence post remains about 24 inches below ground line. The corner monument is in an active wheat field. The monument cap is 15" below ground line.

New accessories:

- A 5/8" by 30" rebar with 1 1/4" red plastic cap bears N 32° E, 42.3 feet.
- A 5/8" by 30" rebar with 1 1/4" red plastic cap bears N 02° E, 31.8 feet.
- A 5/8" by 24" rebar with 1 1/4" red plastic cap bears N 42° W, 49.4 feet.
- A 5/8" by 30" rebar with 1 1/4" red plastic cap bears N 59° W, 93.5 feet.

Red plastic caps are marked "ORPLS 1106 WAPLS 17372". Set steel fence post N 02° E, 32 feet from corner monument with "witness" sign wired to it. Wired "bearing object" signs to each rebar accessory.


LOCATION AND COMMENTS: Corner falls in an active wheat field 25 feet South of the North edge of the field.

FIRM: Wells Surveying
P.O. Box 1696
Pendleton, OR 97801

COMPASS DECLINATION: 18° East

Surveyor's Seal

√2N28N1

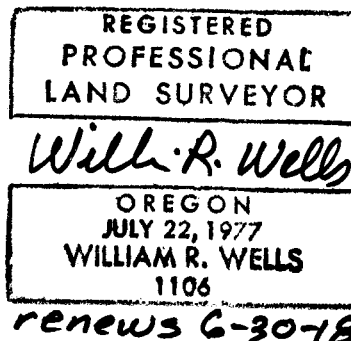

17-065-C