

OREGON CORNER RESTORATION FORM

Section 31 Township 3N Range 29E
County Umatilla Date: 05/05/09

Corner Designation: 3N29Z1

Corner common to sections 31, T3NR29E, 36, T3NR28E, 1, T2N28E, 6, T2N29E.

- Condition Report Only
- Not Found
- Remonumented
- Unrecorded
- Surveyed In
- Referenced Out

Previous Renewals / Surveys, etc.


Originally Surveyed by David P. Thompson. He set a post in a mound of earth in 1859. Wayne Harris found a stone with a cross.

S. Haddock set a 1 3/8" x 30" galvanized iron pipe and 2 3/8" Brass cap in 2004.


Monuments and Accessories Found: (Condition and Source)

- A 2 3/8" Brass cap, in good condition.
- A 3/8" Iron rebar w/opc 56295LS lies N 00°18'30" E, 96.22'.
- A 3/8" Iron rebar w/opc 56295LS lies S 66°43'38" W, 150.44'.
- A 3/8" Iron rebar w/opc 56295LS lies S 06°20'29" E, 47.40'.
- A 3/8" Iron rebar w/opc 56295LS lies S 47°57'06" E, 64.50'.

Diagram

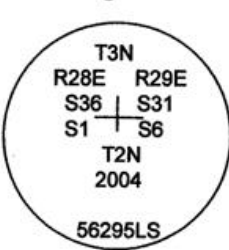

Sketch

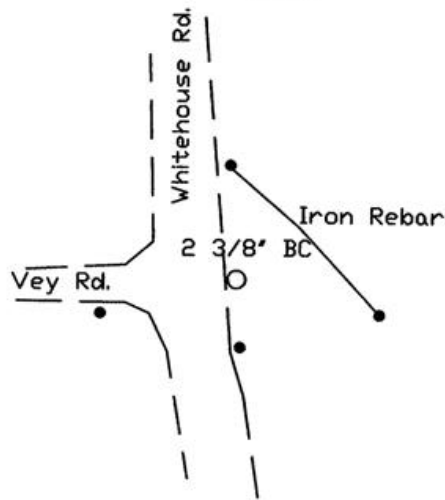

NAD 83/91
OREGON STATE PLANE NORTH
INTERNATIONAL FEET

N739854.25
E8521916.66
LAT - 45° 41' 21.16814" N
LON - 119° 14' 54.42906" W

Monument (s) Set (Procedures and Description)

None

References Set:

None

Location and Comments

The corner is just East of the intersection of Whitehouse Rd. and Vey Road.

Compass Declination
17° E

Surveyors Seal

REGISTERED
PROFESSIONAL
LAND SURVEYOR

Robert D. English
OREGON
JANUARY 11, 2005
ROBERT DOUGLAS ENGLISH
43406LS

RECEIVED BY:

Date: 5-09
Rec'd By: KK
No. 09-82-R

Firm / Agency

Survey One, LLC.
P.O. Box 382
Pendleton, OR 97801
(541) 276-2055

RENEWAL DATE: 12/31/09