

**OREGON CORNER RESTORATION FORM**

Section 34 Township 3N  
County Umatilla Date: 03/08/10

Range 29E

Corner Designation: 3N29Z15

1/4 Corner common to sections 34 T3NR29E, 3 T2NR29E.

Condition Report Only  
 Not Found  
 Remonumented  
 Unrecorded  
 Surveyed In  
 Referenced Out


**Previous Renewals / Surveys, etc.**

Originally Surveyed by David P. Thompson. He set a post in a mound of earth in 1859.  
Harris set 1 1/4" Pipe in Survey Q-76-B.


**Monuments and Accessories Found: (Condition and Source)**

Found 1 1/4" Pipe at Harris's called location.

Diagram

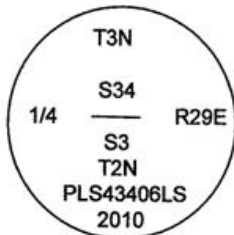

Sketch

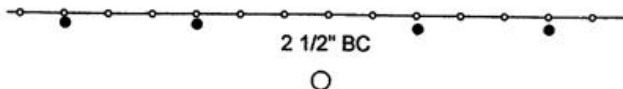

NAD 83/91  
OREGON STATE PLANE NORTH  
INTERNATIONAL FEET

N740404.49  
E8541045.22

LAT - 45° 41' 23.58227111" N  
LON - 119° 10' 24.85960880" W

**Monument (s) Set (Procedures and Description)**

Set a 2 1/2" Brass Cap on 1" i.d. galvanized iron pipe, flush with ground, buried Harris's 1 1/4" X 24" pipe alongside. Cap marked as shown above.

**References Set:**

- A 5/8"x30" Iron rebar w/ypc #43406 lies N 65°20' W, 43.88'.
- A 5/8"x30" Iron rebar w/ypc #43406 lies N 31° W, 21.55'.
- A 5/8"x30" Iron rebar w/ypc #43406 lies N 42°45' E, 26.16'.
- A 5/8"x30" Iron rebar w/ypc #43406 lies N 68° E, 52.88'.

**Location and Comments**

The corner is 2.0 miles East of the cattle guard at the South end of Snow Road along the East-West fence.

Compass Declination  
17° E

**Surveyors Seal**

REGISTERED  
PROFESSIONAL  
LAND SURVEYOR  
*Robert D. English*  
OREGON  
JANUARY 11, 2005  
ROBERT DOUGLAS ENGLISH  
43406LS

**RECEIVED BY:**

Date: 3-10  
Rec'd By: KK  
No. 10-50-R

**Firm / Agency**

Survey One, LLC.  
P.O. Box 382  
Pendleton, OR 97801  
(541) 276-2055

RENEWAL DATE: 12/31/11