

OREGON CORNER RESTORATION FORM

Section 34,35 Township 3N
County Umatilla Date: 01/24/11

Range 29E

Corner Designation: 3N29Z17

Corner common to Sections 34,35 T3NR29E, and 2,3 T2NR29E.

_____	Condition Report Only
_____X_____	Not Found
_____X_____	Re monumented
_____	Unrecorded
_____X_____	Surveyed In
_____X_____	Referenced Out

Previous Renewals / Surveys, etc.

Originally Surveyed by David P. Thompson. He set a post in a mound of earth in 1859.

Monuments and Accessories Found: (Condition and Source)

Found a 2 1/2" brass cap, in an existing fence line. Corner is East of a fairly new fence intersection. Corner set by Edwards under contract with Umatilla County Surveyor.

A 5/8" Iron rebar w/ypc #951 lies S 70°30' W, 54.27'.

A 5/8" Iron rebar w/ypc #951 lies S 28°20' W, 108.11'.

A 5/8" Iron rebar w/ypc #951 lies S 86° 40' E, 14.94'.



A 5/8"x30" Iron rebar w/ypc #43406 lies S 89°40' E, 32.64'.

Harris gave a bearing and distance from monuments to the West, and called an old fence intersection from the North at the corner position.

The monument fits Harris's calls.

Sketch

Diagram

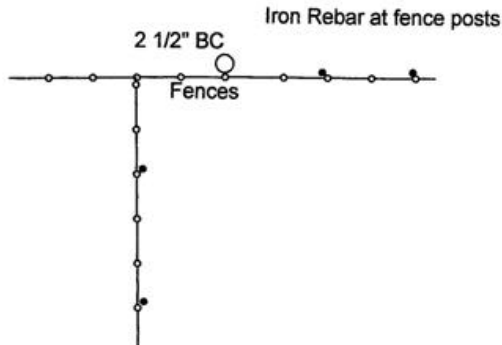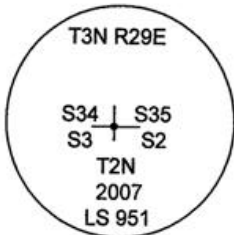

NAD 83/91
OREGON STATE PLANE NORTH
INTERNATIONAL FEET

N740482.18
E8543718.82

LAT - 45° 41' 23.91884" N
LON - 119° 09' 47.18888" W

Monument (s) Set (Procedures and Description)

None.

References Set:

None.

Location and Comments

The corner is 1 mile East from the end of a farm road that goes South from Piercy's vineyard, follow the East-West fence. Getting to this corner is challenging at best.

Compass Declination

17° E

Surveyors Seal

REGISTERED
PROFESSIONAL
LAND SURVEYOR

Robert D. English
OREGON
JANUARY 11, 2005
ROBERT DOUGLAS ENGLISH
43406LS

RECEIVED BY:

Date: 1-4
Rec'd By: KK
No. 11-31-R

Firm / Agency

Survey One, LLC.
P.O. Box 382
Pendleton, OR 97801
(541) 276-2055

RENEWAL DATE: 12/31/11