

OREGON CORNER RESTORATION FORM

Section 35 Township 3N
County Umatilla Date: 03/08/10

Range 29E

Corner Designation: 3N29Z19

Corner common to sections 35 T3NR29E, 2 T2NR29E.

_____	Condition Report Only
_____X_____	Not Found
_____X_____	Re monumented
_____	Unrecorded
_____X_____	Surveyed In
_____X_____	Referenced Out


Previous Renewals / Surveys, etc.

Originally Surveyed by David P. Thompson. He set a post in a mound of earth in 1859.


Monuments and Accessories Found: (Condition and Source)

None.

Diagram

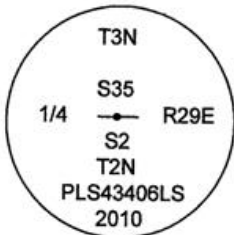

Sketch

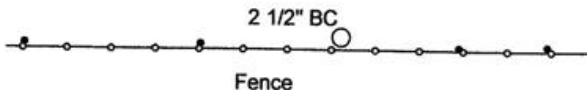

NAD 83/91
OREGON STATE PLANE NORTH
INTERNATIONAL FEET

N740542.73
E8546363.16

LAT - 45° 41' 24.08294" N
LON - 119° 09' 09.92739" W

Monument (s) Set (Procedures and Description)

Set a 1"x30" galvanized iron pipe with 2 1/2" brass cap, flush with ground, by single proportionate method, marked as shown above.

References Set:

- A 5/8"x30" Iron rebar w/ypc #43406 lies East, 50.82'.
- A 5/8"x30" Iron rebar w/ypc #43406 lies S 89° E, 16.41'.
- A 5/8"x30" Iron rebar w/ypc #43406 lies S 88°30' W, 13.80'.
- A 5/8"x30" Iron rebar w/ypc #43406 lies S 89°15' W, 28.34'.

Location and Comments

The corner is 1.5 miles East from the end of a farm road South from Piercy's Vineyard the East-West fence. Access is challenging.

Compass Declination

17° E

Surveyors Seal

REGISTERED
PROFESSIONAL
LAND SURVEYOR

Robert D. English
OREGON
JANUARY 11, 2005
ROBERT DOUGLAS ENGLISH
43406LS

RECEIVED BY:

Date: 1-11
Rec'd By: RE
No. 11-21-R

Firm / Agency

Survey One, LLC.
P.O. Box 382
Pendleton, OR 97801
(541) 276-2055

RENEWAL DATE: 12/31/11