

CERTIFIED RECORD OF LAND CORNER MONUMENTATION

Corners to Sections 9, 10, 15 and 16, T.2N, R.31E., WM.

Index: J-13

History of original corner establishment:

Corner originally set by Josiah Burnett in contract 92 dated 1860. His record reads: Set a post for corner to Secs. 9, 10, 15 and 16, drove a stake and raised mound with trench as per instructions.

In 1897, C. B. Wade surveyed in sections 15 and 16 and recorded his survey as Survey No.92 in book 1 of Umatilla County Surveys. His record reads:

I commenced at the corner to Secs 9-10-15 & 16 which is the old gov. post in a mound of stone.

A railroad survey on record with the Umatilla County Surveyor records this corner as existing in 1947 and 2688.6' north of the quarter corner common to sections 15 and 16.

Evidence Found: Found a large mound of stone with rotten stake in the center and survey lath nearby. This mound was 2686.78' north of the quarter corner set by the same survey.

Description of monument and accessories I established to perpetuate the original location of this corner:

I set a 1.25" O.D. x 30" galvanized iron pipe with 2.25" brass cap stamped as shown in the diagram above. The pipe was set 4" in the ground on bedrock. Constructed large mound of stone around the monument with a 6' steel fence post and Umatilla County Land Survey Monument sign attached from which:


- a rebar bears S74°58'58"W, 69.94' in a rock outcrop;
- a rebar bears S31°41'22"E, 106.55' in a rock outcrop;
- a rebar bears N29°24'16"W, 47.02' in a rock outcrop;
- a rebar bears N75°45'04"E, 249.49' in an shallow soil with a 6' steel fence post and bearing object sign.

Each rebar is 5/8" x 24" and has a 1.25" diameter red plastic cap, stamped ORLS0852 and WAL513922, and a bearing object sign attached to the rebar.

The bearings are based on the railroad main line being N85°18'00"W.

This work was done March 26, 1997 and witnessed by Charles McFarlan.

Office of County Surveyor County of Umatilla
 State of OR, I hereby certify that the within instrument was filed
 in this office for record on the 15th day of April, 1997.
 _____ by _____
 (COUNTY OFFICIAL) (DEPUTY)

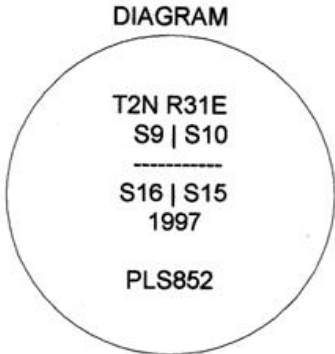

REGISTERED
 PROFESSIONAL
 LAND SURVEYOR

David L. Haddock

OREGON
 JULY 12, 1859
 DAVID L. HADDOCK
 352

RECEIVED BY
 Umatilla County Surveyor
 Date 4-97
 Rec'd by XX
 No. 97-63-B