


CERTIFIED RECORD OF LAND CORNER MONUMENTATION

Quarter corner to Sections 15 and 16, T.2N, R.31E., WM. Index: L-13

History of original corner establishment:  
Corner originally set by Josiah Burnett in contract 92 dated 1860. His record reads: Set a post for 1/4 Sec. corner, from which a Balm Gilliad, 9 in. diam. bears S.4°30'W., 105 links distant; A Balm Gilliad 12 in diam. bears N.19°E., 306 links distant

DIAGRAM

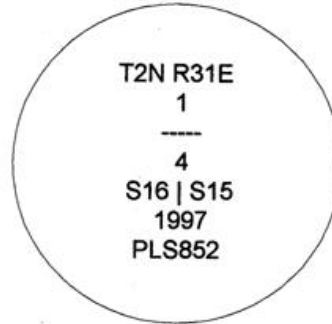

In 1897, C. B. Wade surveyed in sections 15 and 16 and recorded his survey as Survey No.92 in book 1 of Umatilla County Surveys. His record reads:  
Set stone 16x5x4 for 1/4 sec cor bet secs 15 & 16, from which:  
I mark a Cottonwood 24 ins diameter South 12 lks dist,  
a cottonwood 18 ins diameter brs N45°W, 12 lks dist.

In 1967, Ralph Thompson, Oregon LS 506, found Wade's record stone, set two 1/2" pins southerly stone, and filed his work as survey O-12-B.

Evidence Found: Found Wade's stone, with clearly chiseled 1/4, loose on the ground.  
Found Thompson's two pins in undisturbed condition.  
Found a 1.5" axle driven in the ground near the corner location.

Description of monument and accessories I established to perpetuate the original location of this corner:  
Using Thompson's two pins as references, I set a 1.25" O.D. x 30" iron pipe with a 2.25" brass cap, stamped as shown in the diagram above, for the 1/4 corner from which:  
The axle bears N78°14'W;  
a rebar bears N62°29'49"E, 90.52' at the base of a railroad tie in an east west fence line;  
a rebar bears S47°31'10"E, 107.13' beneath an east west fence line;  
a rebar bears S48°56'05"W, 79.75' at the base of a railroad tie south of a gate in a north south fence line.  
Each rebar is 5/8" x 24" and has a 1.25" diameter red plastic cap, stamped ORLS0852 and WALS13922.  
The bearings are based on the railroad main line being N85°18'00"W.  
A Umatilla County Land Survey Monument sign is attached to a fence post near the corner. Bearing object signs are attached to fence posts near the rebars.

REGISTERED  
PROFESSIONAL  
LAND SURVEYOR

*David L. Haddock*

OREGON  
JULY 12, 1968  
DAVID L. HADDOCK  
052

This work was done March 23, 1997 and witnessed by Stephan Haddock.

Office of County Surveyor County of Umatilla  
State of OR, I hereby certify that the within instrument was filed  
in this office for record on the 15<sup>th</sup> day of April, 1997.  
by \_\_\_\_\_  
( COUNTY OFFICIAL ) ( DEPUTY )

RECEIVED BY  
Umatilla County Surveyor  
Date 4-97  
Rec'd by AK  
No. 97-63-B