


CERTIFIED RECORD OF LAND CORNER MONUMENTATION

Quarter corner to Sections 15 and 22, T.2N, R.31E., WM. Index: N-15

History of original corner establishment:  
Corner originally set by Josiah Burnett in contract 92 dated 1860. His record reads: 40.11 Set a post for 1/4 Sec. corner. drove charred stake and raised mound with trench as per instructions.

DIAGRAM

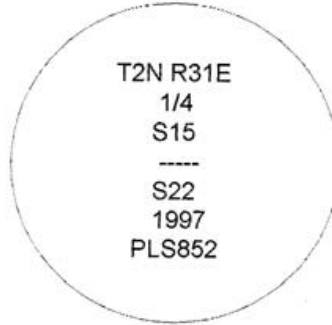

In 1897, C. B. Wade surveyed in sections 15 and 16 and recorded his survey as Survey No.92 in book 1 of Umatilla County Surveys. His record reads: 40.13 could find no signs of 1/4 sec cor. 47.00 head of a draw course north. He then proportioned the corner. His record reads 40.18 set stone marked 1/4 raised mound and dug pits E and W.

Evidence Found: Found 18" long boot shaped stone 5" by 4" top and 10" by 14" firmly set 14" in the ground, small end up, with a charcoal deposit under it. The stone was located on the remains of an east-west fence. The stone was 7 chains east of the head of a draw going north towards the Umatilla River.

Description of monument and accessories I established to perpetuate the original location of this corner:

I set a 1.25" O.D. x 30" galvanized iron pipe with 2.25" brass cap stamped as shown in the diagram above. The pipe was set 24" in the ground. Constructed stone collar around the monument. Set a 6' steel fence post with Umatilla County Land Survey Monument sign attached from which:

- a rebar bears S15°17'53"W, 45.90';
- a rebar bears S83°08'28"E, 47.11';
- a rebar bears N79°27'38"W, 49.38';
- a rebar bears N15°02'12"E, 46.94'.

Each rebar is 5/8" x 24" and has a 1.25" diameter red plastic cap, stamped ORLS0852 and WAL513922.

The bearings are true based on GPS observations.

This work was done April 30, 1997.

Office of \_\_\_\_\_ County of \_\_\_\_\_  
 State of \_\_\_\_\_, I hereby certify that the within instrument was filed  
 in this office for record on the \_\_\_\_\_ day of \_\_\_\_\_, 19\_\_\_\_.  
 \_\_\_\_\_ by \_\_\_\_\_  
 ( COUNTY OFFICIAL ) ( DEPUTY )

REGISTERED PROFESSIONAL LAND SURVEYOR

David L. Haddock

OREGON JULY 12, 1968 DAVID L. HADDOCK 852

RECEIVED BY  
 Umatilla County Surveyor  
 Date 6-98  
 Rec'd By KK  
 No. 98-121-B  
 36