


CERTIFIED RECORD OF LAND CORNER MONUMENTATION

Corner to Sections 13, 14, 23 and 24, T.2N, R.31E., WM. Index: N-21

History of original corner establishment:
Corner originally set by David Thompson in contract dated July 1859. His record reads: Set a post and mound for corner 13, 14, 23, and 24, drove a stake and raised mound as per instructions.

DIAGRAM

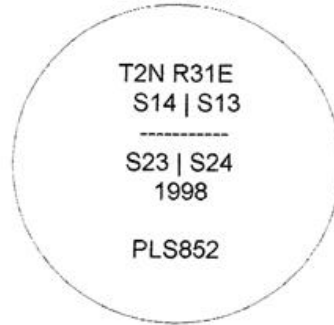

Evidence Found: Found intersection of existing north south fence line with line of old fence rockjacks going east and west.

Description of monument and accessories I established to perpetuate the original location of this corner:

I set a 1.25" O.D. x 30" galvanized iron pipe with 2.25" brass cap stamped as shown in the diagram above. The pipe was set 18" in the ground on bedrock. Monument is south and east of a large fence rock crib. Constructed stone collar around the monument and attached. Umatilla County Survey Monument sign to rock crib above monument from which:
a rebar bears N00°47'E, 67.08' under the north south fence line with bearing object sign attached;
a rebar bears N89°15'E, 61.99' in an old rock jack stone mound;
a rebar bears S0°38'W, 49.21' under the north south fence line with bearing object sign attached;
a rebar bears S88°00'W, 59.96' in an old rock jack stone mound;
sign.
Each rebar is 5/8" x 24" and has a 2 3/8" diameter red plastic cap, stamped ORLS0852 and WAL513922.
The bearings are true.

This work was done May 7, 1998.

Office of _____ County of _____
State of _____, I hereby certify that the within instrument was filed
in this office for record on the _____ day of _____, 19____.

(COUNTY OFFICIAL) by _____
(DEPUTY)

REGISTERED
PROFESSIONAL
LAND SURVEYOR

David L. Haddock

OREGON
JULY 12, 1969
DAVID L. HADDOCK
852

RECEIVED BY

Umatilla County Surveyor

Date _____

Rec'd By _____

No. 98-121-B