


CERTIFIED RECORD OF LAND CORNER MONUMENTATION

Corner to Sections 13, 14, 23 and 24, T.2N, R.31E., WM. Index: N-23

History of original corner establishment:
 Corner originally set by David Thompson in contract dated July 1859. His record reads: Set a post and mound for 1/4 corner Secs. 13 and 24, drove a stake and raised mound as per instructions.

DIAGRAM

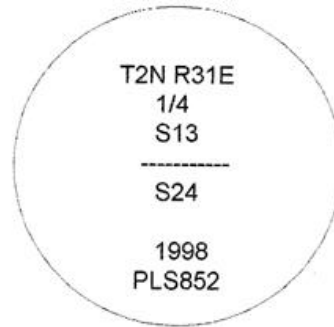

Evidence Found: Existing north south fence line.

Description of monument and accessories I established to perpetuate the original location of this corner:

At intersection of north south fence line and line between southwest and southeast corners of Section 13, I set a 1.25" O.D. x 30" galvanized iron pipe with 2.25" brass cap stamped as shown in the diagram above. The pipe was set 18" in the ground on bedrock. Monument is at base of a small fence rock jack between two large rock cribs. Constructed stone collar around the monument. Attached a Umatilla County Survey Monument sign to post monument from which:
 a rebar bears N00°18'W, 77.26' in a rock jack;
 a rebar bears N00°23'E, 39.78' at the southwest corner of a rock crib with a bearing object sign attached;
 a rebar bears S2°04'E, 32.21' at the southwest corner of a rock crib;
 a rebar bears N77°05'W, 36.69' in a rock outcrop;
 sign.

Each rebar is 5/8" x 24" and has a 2 3/8" diameter red plastic cap, stamped ORLS852, WAL513922, HADDOCK SURVEYING.

The bearings are Pendleton Grid.

This work was done May 26, 1998.

Office of _____ County of _____
 State of _____, I hereby certify that the within instrument was filed
 in this office for record on the _____ day of _____, 19____.

 (COUNTY OFFICIAL)

by _____
 (DEPUTY)

**REGISTERED
 PROFESSIONAL
 LAND SURVEYOR**

David L. Haddock

**OREGON
 JULY 12, 1988
 DAVID L. HADDOCK
 852**

RECEIVED BY

Umatilla County Surveyor

Date _____

Rec'd By _____

No. 98-121-B