

OREGON CORNER RELOCATION FORM

Section 9 Township 2N Range 32E
 County Umatilla Date: August 20, 2003

Corner Designation: 2N32G12

Center East 1/16th to Section 9, T2N, R32E, W.M.,
 Umatilla County, Oregon.

- Condition Report Only
- Not found
- Remonumented
- Unrecorded
- Surveyed in
- Referenced out


Previous Renewals / Surveys, etc.

Corner originally set by City of Pendleton Engineer Mr. Archie French on March 23, 1954 under survey Q-225-B which is also recorded as survey 89-121-B. His record states "set iron pin". Mr. Stan Wallulis under survey Q-228-C in 1961 said he found a wood hub with a tack and a 1 1/2" solid iron pin 2 feet below the surface. Mr. Wallulis stated that he placed a concrete monument at the surface of the ground. Mr Dave Krumbain in survey 88-85-C stated that all monuments from the Wallulis survey were lost.

Monument and Accessories found: (condition and source)

I found a 1 1/2" iron pin inside a 12" well casing in a substantial concrete monument case. The lid to the monument case was 2 feet below the current surface of the ground. Ties to other found Wallulis monuments from the 1961 survey show that this monument is undisturbed.

- SKETCH
- ⊙ = 1 1/2" Iron pin in concrete monument case.
 - = 1/2" Iron Rebar From survey Q-228-C.
- L1 = S84°48'09"E 284.80'
 (S84°49'E, 284.80') Q-228-C
- L2 = N0°35'40"W, 1081.85'
 (N0°36'08"W, 1082.00') Q-228-C

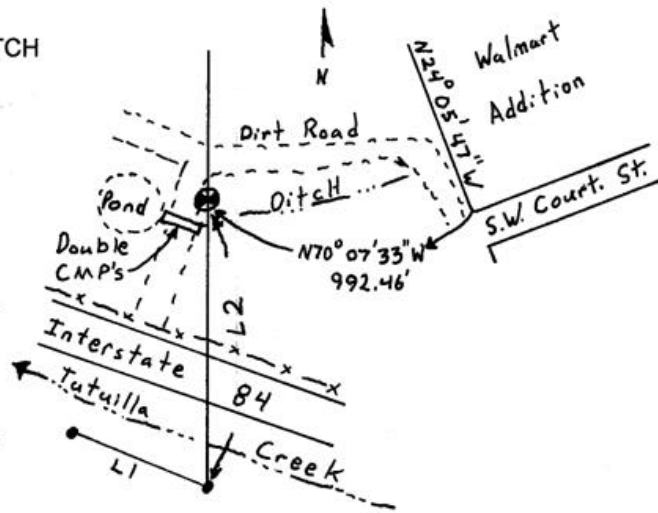

MONUMENT (S) AND ACCESSORIES SET (Procedures and Description)

I placed a 5' steel guard post in the lid to the monument case. I attached a Umatilla County Monument Sign to the post.

For references:
 None.

The monument and references were tied using a LIECA system 300 RTK GPS.

Location and comments

Compass Declination

Surveyors Seal

RECEIVED BY:
Umatilla County Surveyor
 Date: 3-04
 Rec'd By: KF
 No. 04-09-B

Firm / Agency
 Witness Tree Surveying
 Address
 P.O. Box G
 Pilot Rock, Or. 97868
 Party Chief
 Stephen K, Haddock

REGISTERED
 PROFESSIONAL
 LAND SURVEYOR

Stephen K. Haddock

OREGON
 JULY 9, 2001
 STEPHEN K. HADDOCK
 56295LS

RENEWAL DATE 6-30-05