


CERTIFIED RECORD OF LAND CORNER MONUMENTATION

Submitted by City Engineer's Office
City Engineer *Howard R. Kimbrell*

Pendleton, Oregon

History of original corner establishment:
The basalt stone was set in 1880's as the interior monument #8 for the Reservation Addition.

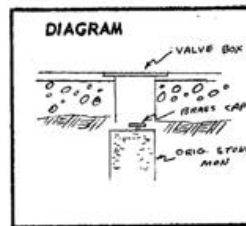


Description of corner evidence found:

Found a basalt stone 6" x 8" and appeared to be about 3' long. The top had been broken off but two chisled cross were found on the curb that were placed by Gary Kimbrell when he was County Surveyor.

Description of monument and accessories established to perpetuate the original location of this corner

From the two crosses on the curb set a City of Pendleton brass cap 10.00 feet from each cross and punched it for true position. Reference points and distances were verified by Wayne Harris, the brass cap is stamped "Int. Res. B. Mon. #8" and is set in a valve box.

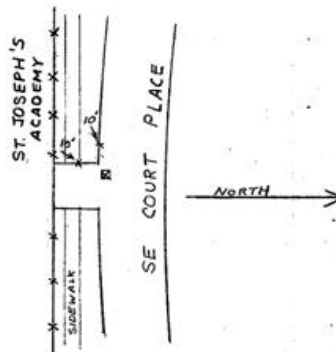

Office of County Surveyor County of Umatilla
State of Oregon I hereby certify that the within instrument was filed in this office
for record on the 16 day of January, 1969, at 11 o'clock A.M., (signed)
Ralph O. Thompson by
(COUNTY OFFICIAL) (DEPUTY)

Q-357