

**PUBLIC LAND CORNER CONDITION REPORT**

**UMATILLA COUNTY, DATE: 09/19/01**

**CORNER DESIGNATION:** 2N32, X-21, the East 1/4 Corner of Section 35.

**PREVIOUS RENEWALS/ SURVEYS, ETC.:**

Most recent is Umatilla County Surveyors Recording Number for Certificate: 94-109-C.

**MONUMENT AND ACCESSORIES FOUND:**

Found 2 1/2" brass cap on a 1 1/4" x 30" galvanized iron pipe with top 14 inches below ground, marked as shown in monument marking detail, good condition. As per Corner Record, all accessories exist except: Steel fence post with "witness" sign missing for accessory at S 45° E, 26.6 feet and the power pole in the SW quadrant has been removed.

This corner had four accessories, the pole in the SW quadrant is now gone.

**MONUMENT MARKING DETAIL:**

1/4  
S35|S36  
1994  
PLS 1106

**LOCATION & COMMENTS:**


Approximately 50 feet East of centerline of Tutuilla Road and approximately 40 feet South of fence running East.

**STATE PLANE COORDINATE, OREGON NORTH ZONE, NAD83/91, INT. FOOT:**


N = 712970.98  
E = 8645811.76

**FIRM/AGENCY:** William R. Wells, PLS  
P.O. Box 1696  
Pendleton, Oregon 97801

2N32X21

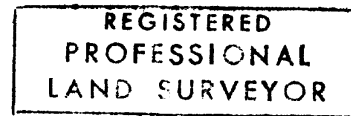

*Will. R. Wells*

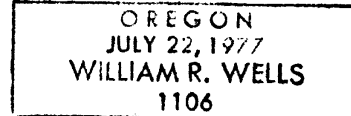

*renews 6-30-02*

RECEIVED BY

Umatilla County Surveyors

Date 12-01

Rec'd By KE

No. 01-210-9