

**OREGON CORNER RESTORATION FORM**

Section 6 Township 1N Range 32E  
 County Umatilla Date: August 5, 2009

Corner Designation: 1N32A1

Condition Report Only  
 Not found  
 Remonumented  
 Unrecorded  
 Surveyed in  
 Referenced out

Corner to section 31, T2N, R32E, section 36, T2N, R31E, section 1, T1N, R31E, and section 6, T1N, R32E, W.M., Umatilla County, Oregon.


Previous Renewals / Surveys, etc.

Corner originally set by Josiah A. Burnett under contract No. 92 dated September 12, 1860. His record reads: Set post, and drove charred stake, raised mound with trench. In survey 93-54-C Mr. Bill Wells set a brass cap and states: Accepted ancient fence corner.

Monument and Accessories found: ( condition and source )

The brass cap set by Mr. Wells is still in good condition and marked as shown below. I did not search for the references.

**DIAGRAM**

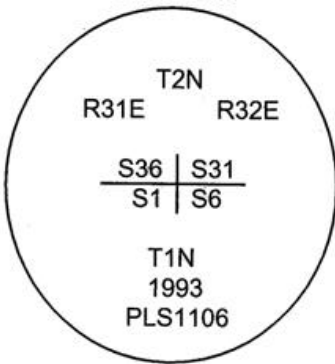

**SKETCH**

**Monument and Accessories set:**

None. This certificate is prepared to report the NAD 83/1991 state plane coordinates only.

The monument was tied using a Trimble R7/R8 RTK GPS SYSTEM in static mode.

Location and comments

Compass Declination

Surveyors Seal

NAD 83/1991 State Plane Coordinates

Oregon North Zone

N = 709,944.98 ift

E = 8,618,848.50 ift

Firm / Agency

Witness Tree Surveying

Address

P.O. Box G

Pilot Rock, Or. 97868

Party Chief

Stephen K, Haddock

RECEIVED BY:

Umatilla County Surveyor

Date: 6-10

Rec'd By: KK

No. 10-93-C

REGISTERED  
 PROFESSIONAL  
 LAND SURVEYOR

*Stephen K. Haddock*

OREGON  
 JULY 9, 2001  
 STEPHEN K. HADDOCK  
 56295LS

RENEWAL DATE 6-30-11