

OREGON CORNER RESTORATION FORM

Section 2 Township 1N Range 32E
County Umatilla Date: July 29, 2009

Corner Designation: 1N32A19

Condition Report Only
 Not found
 Remonumented
 Unrecorded
 Surveyed in
 Referenced out

Common quarter corner to section 35, T2N, R32E and section 2, T1N, R32E, W.M., Umatilla County, Oregon.


Previous Renewals / Surveys, etc.

Corner originally set by David P. Thompson under contract #106 dated August 16, 1864. His record reads: Set post for 1/4 sec. corner in mound of earth with charred stake, pits, trench &c. Zenas Moody, under contract No. 164, dated October 4, 1871 states set post and made earth mound for 1/4 sec. cor. James Currin and James Noland under special instructions dated May 4, 1887 states: Set a basalt stone in old mound 12x12x10 marked 1/4 on N. face. The US Dept. of AG. in survey H-251-B states: Fence corner N. & E. Set Mon. Mr. Bill Wells, in survey 94-109-C states: Found 3" brass cap on iron pipe.

Monument and Accessories found: (condition and source)

I found the 3" Bureau of Reclamation Brass Cap stamped as shown in the diagram below.

DIAGRAM

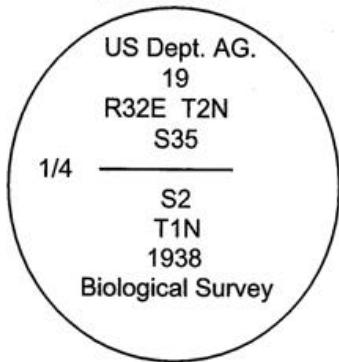

SKETCH

MONUMENT (S) AND ACCESSORIES SET (Procedures and Description)
None. This certificate is to report the state plane coordinates only.

The monument was tied using a Trimble R7/R8 RTK GPS.

Location and comments
NAD 83/1991 State Plane Coordinate
Oregon North Zone.
N = 710,291.33 ift
E = 8,643,217.70 ift

Compass Declination

Firm / Agency
Witness Tree Surveying
Address
P.O. Box G
Pilot Rock, Or. 97868
Party Chief
Stephen K, Haddock

Surveyors Seal

RECEIVED BY:
Umatilla County Surveyor
Date: 6-10
Rec'd By: KK
No. 10-93-C

REGISTERED
PROFESSIONAL
LAND SURVEYOR

Stephen K. Haddock

OREGON
JULY 9, 2001
STEPHEN K. HADDOCK
56295LS

RENEWAL DATE 6-30-11