

**OREGON CORNER RESTORATION FORM**

Section 6 Township 1N Range 32E  
 County Umatilla Date: August 24, 2009

Corner Designation: 1N32A5


Corner common to sections 31 and 32, T2N, R32E, and sections 5 and 6, T1N, R32E, W.M., Umatilla County, Oregon.

Condition Report Only  
 Not found  
 Remonumented  
 Unrecorded  
 Surveyed in  
 Referenced out

Previous Renewals / Surveys, etc.


Corner originally set by David P. Thompson under contract No. 106 dated August 16, 1864. His record reads: Set post for corner to secs. 5, 6, 31 & 32 in mound of earth with charred stake, pits, trench, &c. as per instructions.

Monument and Accessories found: ( condition and source )  
 None. This point falls in a plowed field.

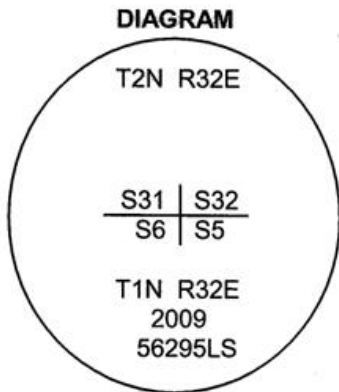

⊗ = Set Brass Cap  
 ● = Rebar Reference

SKETCH

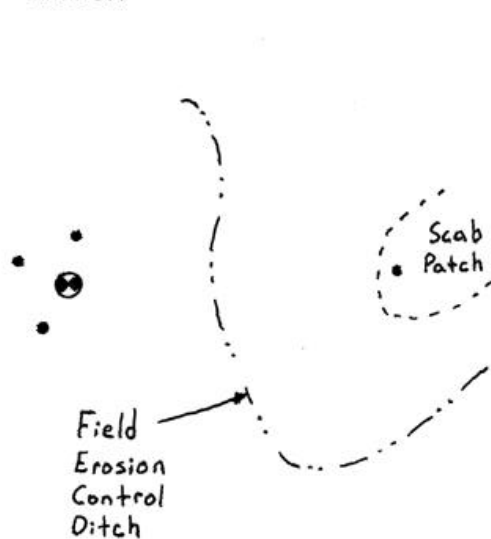

**Monument and Accessories set:**

Set a 2 1/2" brass cap on a 30" galvanized iron pipe stamped as shown in the diagram above at the proportionate point. The cap is 20" below the surface of a plowed field.

For references, I set four 5/8" x 24" iron rebars with 1 1/4" orange plastic caps stamped WTS and 56295LS as described below.

- an iron rebar bears N04°20'24"E, 35.82 feet, 2 feet below the surface of the field;
- an iron rebar bears N75°49'33"W, 32.73 feet, 2 feet below the surface of the field;
- an iron rebar bears S27°59'24"W, 36.28 feet 2 feet below the surface of the field;
- an iron rebar bears N80°38'16"E, 548.76 feet in a scab rock patch in the field;

The monument and references were tied using a Trimble R7/R8 RTK GPS System.

Location and comments  
 NAD 83/1991 State Plane Coordinates  
 Oregon North Zone.  
 N = 709,979.76 ift  
 E = 8,624,755.40 ift

Compass Declination  
 Firm / Agency  
 Witness Tree Surveying  
 Address  
 P.O. Box G  
 Pilot Rock, Or. 97868  
 Party Chief  
 Stephen K, Haddock

Surveyors Seal

REGISTERED  
 PROFESSIONAL  
 LAND SURVEYOR

*Stephen K. Haddock*

OREGON  
 JULY 9, 2001  
 STEPHEN K. HADDOCK  
 56295LS

RENEWAL DATE 6-30-11

RECEIVED BY:  
 Umatilla County Surveyor  
 Date: 6-10  
 Rec'd By: KK  
 No. 10-95-c