

OREGON CORNER RESTORATION FORM

Section 5 Township 1N Range 32E
County Umatilla Date: August 4, 2009

Corner Designation: 1N32A7

Common quarter corner to section 32, T2N, R32E and section 5, T1N, R32E, W.M., Umatilla County, Oregon.


Previous Renewals / Surveys, etc.

Corner originally set by David P. Thompson under contract #106 dated August 16, 1864. His record reads: Set stone, 24x14x5 ins. for 1/4 sec. corner. Mr. Bill Wells, in survey 94-109-C set a brass cap. His record states: found 18"x12"x5" stone marked "1/4" at fence intersection.

Monument and Accessories found: (condition and source)
I found the brass cap set by Wells in good condition as described.

Condition Report Only
 Not found
 Remonumented
 Unrecorded
 Surveyed in
 Referenced out

DIAGRAM

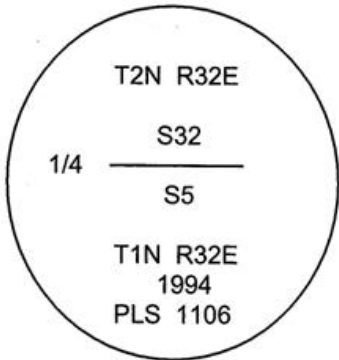

SKETCH

MONUMENT (S) AND ACCESSORIES SET (Procedures and Description)
None. This certificate is to report the state plane coordinates only.

The monument was tied using a Trimble R7/R8 RTK GPS.

Location and comments
NAD 83/1991 State Plane Coordinate
Oregon North Zone.
N = 709,972.38 ift
E = 8,627,407.32 ift

Compass Declination

RECEIVED BY:
Umatilla County Surveyor
Date: 6-10
Rec'd By: KK
No. 10-93-C

Firm / Agency
Witness Tree Surveying
Address
P.O. Box G
Pilot Rock, Or. 97868
Party Chief
Stephen K, Haddock

Surveyors Seal

REGISTERED
PROFESSIONAL
LAND SURVEYOR

Stephen K. Haddock

OREGON
JULY 9, 2001
STEPHEN K. HADDOCK
56295LS

RENEWAL DATE 6-30-11