

OREGON CORNER RESTORATION FORM

Section: 36
Township: 3 North
Range: 33 East of the Willamette Meridian
County: Umatilla
Date: 05/14/02

Corner Indexing Information: Township 3N Range 33E Corner Code Z-25 (Willamette Meridian)

Additional Identifier: (e.g. BLM designation for the corner, street intersection, plat name, block, lot, etc.)

Southeast corner section 36.

Oregon Plane Coordinates: N: 742748.862 E: 8682080.135

Zone: North **Order:** second **Datum:** NAD83-91 **Convergence:** 1°19'55.7" **Scale Factor:** 0.99986645

Previous Renewals/Surveys, etc.:

Corner was originally set by Thompson in 1864 as a post mound and pits, per contract no. 106.

Corner was re-established by Moody in 1871 as a post, per contract no. 145.

Monument was recovered by Redfield in 1918.



In 2001, Wells recovered Redfield's monument and set a 2 1/2" brass cap on 1" pipe, with accessories.

Monument(s) & Accessories Found (Condition & Source):

Found a 2 1/2" brass cap on a 1" pipe, by Wells. Accessories are noted below.

Monument Set (Procedures & Description):

Monument Detail:

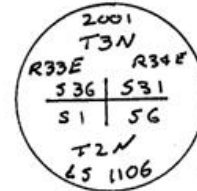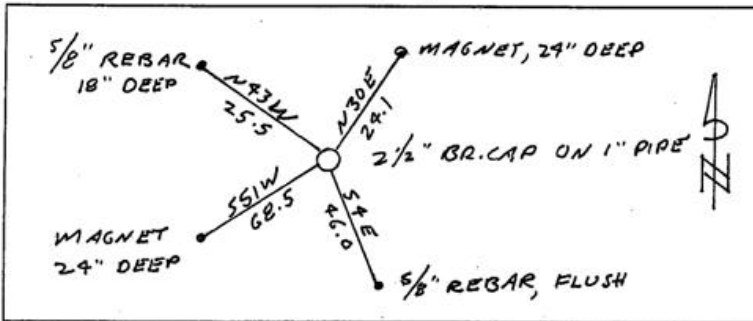

Location & Comments:

Compass Declination:

19° East

Firm/Agency: Tomkins Land Surveying, Inc.
 20 E. Poplar, Suite 204
 Walla Walla WA 99362

Party Chief: PWPT

Notes:

Witness:

Surveyor's Seal

REGISTERED
 PROFESSIONAL
 LAND SURVEYOR

Paul W. P. Tomkins

OREGON
 JULY 26, 1988
 PAUL W. P. TOMKINS
 2360

renews 6/30/04

2/11/03

RECEIVED BY
 Umatilla County Surveyor
 Date 2-03
 Rec'd By JK
 No. 12-21-0