

PUBLIC LAND CORNER CONDITION REPORT

UMATILLA COUNTY, DATE: 01/10/02

CORNER DESIGNATION: 2N33N25, The Northeast Corner of Section 24.

PREVIOUS RENEWALS/ SURVEYS, ETC..:

Most recent Umatilla County Surveyors recorded survey: 89-74-C.

MONUMENT AND ACCESSORIES FOUND:

At road intersection found 20 penny spike, for corner to Sections 13, 18, 19 and 24, buried 4" below road surface.

MONUMENT MARKING DETAIL:

LOCATION & COMMENTS:

Located near intersection of Niktyoway Way (North-South Road) and field roads East and West.


STATE PLANE COORDINATE, OREGON NORTH ZONE, NAD83/91, INT. FOOT:

N = 727090.83


E = 8682425.85

FIRM/AGENCY: William R. Wells, PLS
P.O. Box 1696
Pendleton, Oregon 97801

2N33N25

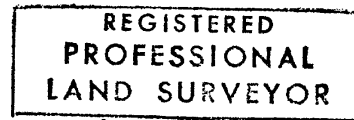

William R. Wells

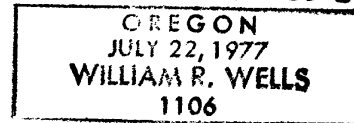

renews 6-30-02

RECEIVED BY

Umatilla County Surveyors

Date 2-02

Rec'd By KK

No. 02-43-9