

PUBLIC LAND CORNER CONDITION REPORT

UMATILLA COUNTY, DATE: 03/06/02

CORNER DESIGNATION: 2N33X9, The East 1/4 Corner of Section 32.

PREVIOUS RENEWALS/ SURVEYS, ETC..:

Most recent Umatilla County Surveyors recorded survey record: 98-232-B.

MONUMENT AND ACCESSORIES FOUND:

Found railroad spike 2" below paved road (Montanic Road) in North bound lane with a field line East and a fence line West. Monument marked as shown in monument marking detail. No visible accessories.

MONUMENT MARKING DETAIL:

None.

LOCATION & COMMENTS:

Located in Northbound Lane of Montanic Road.


STATE PLANE COORDINATE, OREGON NORTH ZONE, NAD83/91, INT. FOOT:

N = 713308.52


E = 8661483.71

FIRM/AGENCY: William R. Wells
P.O. Box 1696
Pendleton, Oregon 97801

2N33X9

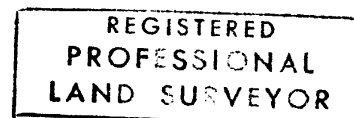

William R. Wells

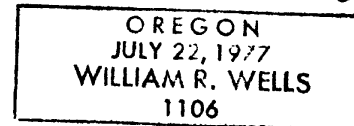

renews 6/30/02

RECEIVED BY

Umatilla County Surveyor

Date 5-02

Rec'd By KK

No. 02-124-9