

A-17

OREGON CORNER RESTORATION FORM


A-17

Section 3 Township 1N Range 34E

County Umatilla Date 9/30/87

Corner Designation

Section Corner
2, 3, 34, and 35

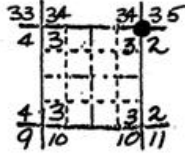

- Condition Report Only
- Not Found
- Renewed
- Unrecorded
- Surveyed In
- Referenced Out

Previous Renewals/Surveys, etc.

Gov't. Indian Allotment survey, 1919.


Monument(s) & Accessories Found: (Condition and Source)

Found brass cap on 2" iron pipe out of ground and leaning against a wood fence post in a north-south fence line. Only wood post in fence, the rest are metal posts. No BT's found. For the purpose of this survey, accepted wood fence post as the position for the corner.

Monument Detail



Sketch

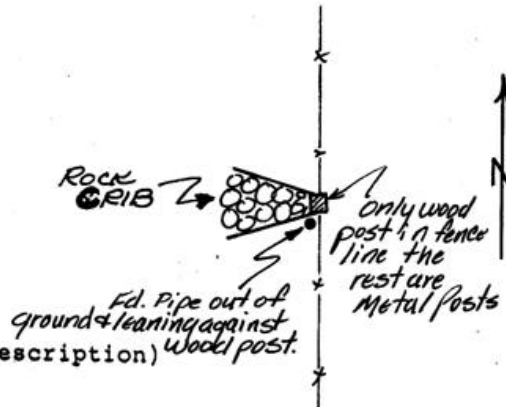

Monument Set (Procedures and Description)

New Accessories

Location & Comments

Blue Mountain Forest
 Wayside boundary
 survey, SE 1/4 Sec. 4, &
 S 1/2 Sec. 3.

Compass Declination 20°

Firm/Agency Oregon State
 Parks & Recreation Div.

Address 525 Trade Street SE
 Salem OR 97310

Party Chief R. Hill

Notes R. Hill

Witness H. Hanson

Seal

REGISTERED
 PROFESSIONAL
 LAND SURVEYOR

John E. Hollingsworth

OREGON
 JULY 9, 1905
 JOHN E. HOLLINGSWORTH
 691

RECEIVED BY

Umatilla County Surveyor

Date 2-88

Rec'd By KA

No. 88-10-B