

USDA-FOREST SERVICE

Index

File No. Z-13

CORNER RECORD (SEARCH)

(Ref. FSM 7151.4)

Tract or

Survey No. _____

Cor.

No. _____

T 2N R. 36E

R.D. Walla Walla

County Umatilla

Merid. Willamette

N.F. Umatilla

State Oregon

CORNER DIAGRAM



S33	S34
S4	S3

DESCRIBE CORNER MONUMENT FOUND

Basalt stone 19"x14"x12" lying loose on the ground with two distinct and one indistinct notches on the East and West edges. Stone is exactly 2½ chains West of ridge top.-Record mound of stone of minimal dimensions at best.

DESCRIBE BEARING TREES OR OTHER OFFICIAL ACCESSORIES FOUND

PHOTO IDENTIFICATION DATA

Photo No. 480-229

Filed At. Umatilla N.F.

Object Ident. two I.P.'s

Ident. By L. [Signature]
Signature

DESCRIBE CORNER LOCATION RELATIVE TO NEAR-BY FEATURES, ALSO HOW TO REACH CORNER

PLANE COORDINATE POSITION DATA

State _____ Zone _____

X _____

Y _____

Estab. By _____

Agency

Signature

Larry V. [Signature]

Title
Land Surveyor

Division

Headquarters

Date

6/83

7100-52-(3-68)

CORNER RECORD (PERPETUATION)

MONUMENT: DESCRIBE NEW MONUMENT SET, OR WORK DONE TO PRESERVE EXISTING MONUMENT

Set 2½" x 30" Aluminum pipe with a 2½" Aluminum cap in ground-built mound of stone 5 ft. base 24" high.

ACCESSORIES : DESCRIBE NEW BY'S WITNESS OBJECTS ETC. ESTABLISHED, OR WORK DONE TO PRESERVE EXISTING EVIDENCE

18" D-Fir N40½W-187.4 ft. scribed T2NR36ES33BT and with a 1" Brass disk stamped PLS 896.
40" D-Fir N48E-152.0 ft. scribed T2NR36ES34BT and with a 1" Brass disk stamped PLS 896.

Set 5/8"x30" Iron rod with red plastic cap stamped PLS 896.
S44E-18.9 ft. and S48W-24.0 ft..

Work Done By Larry D. Bishop Title Surveyor Date 6/83 State Registration No. 896
or Agency
Certified Cor. Record Prepared ? Yes No Filed At: Umatilla County Date July 1983

REMARKS

Index File No. Z-13 T. 2N R. 36E M. Tract or Surv. No. Cor. Section 13

USDA-FOREST SERVICE

Index

File No. Z-13

CORNER RECORD (SEARCH)

(Ref. FSM 7151.4)

Tract or Survey No. _____

Cor. No. _____


T 2N R. 36E

R.D. WALLAWALLA County UMATILLA

Merid. WILL

N.F. UMATILLA State OREGON

CORNER DIAGRAM

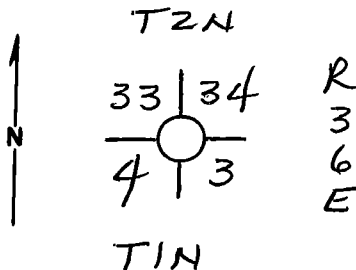

DESCRIBE CORNER MONUMENT FOUND

NONE

DESCRIBE BEARING TREES OR OTHER OFFICIAL ACCESSORIES FOUND

NONE SET

PHOTO IDENTIFICATION DATA

Photo No. _____

Filed At. _____

Object Ident. _____

Ident. By _____

Signature

PLANE COORDINATE POSITION DATA

State _____ Zone _____

X _____

Y _____

Estab. By _____

Agency

Signature

Title

Division

Headquarters

Date

7100-52 (3. 68)

Dennis L. Gaylord PLS 1636

7-22-82

CORNER RECORD (PERPETUATION)

MONUMENT: DESCRIBE NEW MONUMENT SET, OR WORK DONE TO PRESERVE EXISTING MONUMENT

ACCESSORIES : DESCRIBE NEW BT'S WITNESS OBJECTS ETC. ESTABLISHED, OR WORK DONE TO PRESERVE EXISTING EVIDENCE

Work Done By _____ Title _____ Date _____ State Registration No. _____
or Agency _____
Certified Cor. Record Prepared ? Yes No Filed At: _____ Date _____

REMARKS

Index File No. T. R. M. Tract or Surv. No. Cor.