

CERTIFIED RECORD OF LAND CORNER MONUMENTATION

History of original corner establishment:


Original corner established by Charels L. Campbell, under GLO Group No. 733, dated March 22, 1901.

Record states:

At the point of intersection, I set a basalt stone 18x10x5 ins. 12 ins. in the ground for closing cor. of secs. 2 and 3, marked CC on S., 2 grooves on E. and 4 groove on W. faces.

From which:

- A Fir 12 ins. diam. bears S 11° E, 25 lks dist marked T2N R37E S2 BT.
- A Fir 12 ins. diam. bears S 25° W, 19 lks dist marked T2N R37E S3 BT.

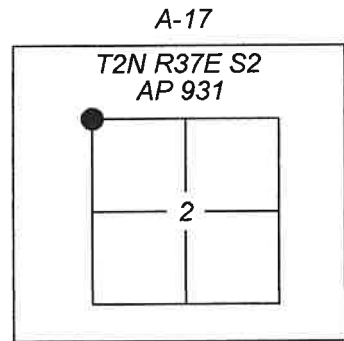


Corner remonumented by Duane I. Griffith, LS 644, as described by Surveyor's Report for Wilderness Boundary Survey under Contract No. 53-04R3-89-81, dated June 26, 1992.

Record states:

At record bearing and distance from the found original tree, I set a 2 1/2" x 30" aluminum pipe with aluminum cap marked as shown, 24 inches in the ground.

From which:

- A 15 inch diameter Douglas fir, bears N 32° E, 15.81 feet marked X BT
- A 5/8 iron rod with yellow plastic cap marked BGA survey marker, bears S 45° E, 4.29 ft. dist.
- A 12 inch diameter Douglas fir, bears S 71° W, 49.71 feet marked T3N R37E S3 BT.
- A 6' steel fence post bears East, 3.22 feet with Land Survey Monument sign attached.

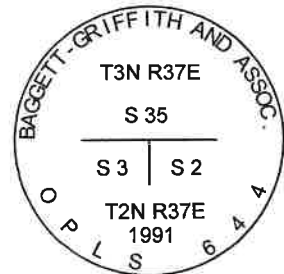

Description of corner evidence found:

Found a 2 1/2 inch aluminum cap, mkd. as shown, on a 2 1/2 inch aluminum pipe, 6 inches above ground, with t-post 3.5.ft. East.

From which:

- A 16 inch Douglas fir, alive with mistletoe, and healed double blaze, bears N 32° E, 15.81 ft. dist.
- A 5/8 iron rod with yellow plastic cap, bears S 45° E, 4.29 ft. dist.
- A 16 inch Douglas fir, alive and healthy, with healed single blaze, bears S 71° W, 49.71 ft. dist.

Description of monument and accessories I established to perpetuate original location of this corner:

New Bearing Tree:

(RM 3) A 12 inch white fir, mkd. X BT on double blaze with 3/4 inch brass tag in face mkd.: LS 91201, and 2 1/2 inch MAG nail in right side center, bears S 49° W, 66.0 ft. dist.

NAD 83 Geodetic Position

Lat. 45°41'14.74" N
Long. 118°09'28.39" W

Established by: Trimble RTK

Bearings are measured to the brass tag, and distances to the MAG nail, where used. All bearing trees are painted with 6 inch red bands, and have Bearing Tree (54-3) and Land Survey Monument (54-9) signs attached.

Posted and marked wilderness boundary S89°33'53"E from corner with Wilderness Boundary (27-6A) signs, and a Land Survey Monument (54-9) sign on nearby post.

Accessories were taken using a Warren Knight staff compass with 14 1/4° East declination, and steel tape.

Witnesses: Kristina Powell, Dewey Bruner and David Quittschreiber
Date: 7-2-19



Kristina Powell



EXPIRES 12-31-20

Office of _____ County Surveyor _____ County of Umatilla
State of Oregon, I hereby certify that the within instrument was filed in this office
for record on the 10th day of December, 2019.
[Signature] by _____
(COUNTY OFFICIAL) (DEPUTY)