

Form 874-9

U. S. DEPARTMENT OF AGRICULTURE
FOREST SERVICE

Union NATIONAL FOREST
CORNERS OF THE PUBLIC SURVEY

T. 27 R. 37 E. 7 Mer.

Section Corner common to Sections
13, 14, 23, and 24

DESCRIPTION OF CORNER

Corner consists of a Rock pile

Dimension above ground 10' x 14' x 14' inches.
Sketch grooves, letters, figures, or notches, on proper face or edge.

CARDINAL POSITION

DIAGONAL POSITION

N	W	S	E

NW	SW	SE	NE

Mound of _____ is located _____

Pits are located _____

Sketch markings of Bearing Trees (or Rocks) in proper box and fill blanks below, giving bearings from Corner to Trees and Distances in Links.

T 27
R 37 E
S 14

--

--

T 27
R 37 E
S 13

BT

--

--

BT

Species Y.P.

Diameter 60"

Bearing N 33 W

Distance 200'

Do you believe this to be a genuine Land Office Corner? Yes

If not, why? _____

[Signature]
Signature

9-22-50
Date


Title

8-3027

T. 27 R. 57 E Mer.

8-3027

(Make sketch of topography near Corner.)

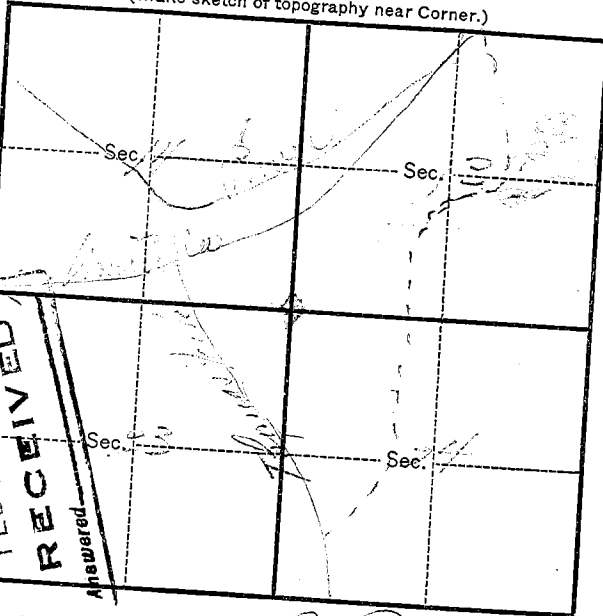


RECEIVED

Answered

Metal Location Poster is on a 20 P
 tree 2 1/2 inches diameter, on the North West
 side of course
 from which this Corner bears S 33 E
8 2/3 rods chains distant.

Give any further facts which will aid in finding this Corner again.

Northwest 1/4 Section P.E.
on trail about 1/2 mile N
shows fork in road from
that road spring