

Index
File No. WB 956

CORNER RECORD (SEARCH)

(Ref. FSM 7151.4)

Tract or
Survey No. _____ Cor.
No. _____


T 2N R. 37E

R.D. WALLA WALLA County UMATILLA

Merid. WILLAMETTE

N.F. UMATILLA State OREGON

CORNER DIAGRAM

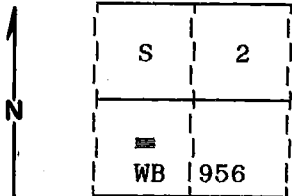

DESCRIBE CORNER MONUMENT FOUND

Corner not previously established.

DESCRIBE BEARING TREES OR OTHER OFFICIAL ACCESSORIES FOUND

No accessories previously established.

PHOTO IDENTIFICATION DATA

Photo No. _____

Filed At. _____

Object Ident. _____

Ident. By _____

Signature

PLANE COORDINATE POSITION DATA

State _____ Zone _____

X _____

Y _____

Estab. By _____

Agency

Signature

Title
SURVEYOR

Division

Headquarters

Date

9-6-91

FS-7100-52 (3/68)

CORNER RECORD (PERPETUATION)

MONUMENTS: DESCRIBE NEW MONUMENT SET, OR WORK DONE TO PRESERVE EXISTING MONUMENT

Set a 2½"x30" aluminum pipe with aluminum cap marked as shown:
Pipe is set 28 inches in the ground.

ELEV 4600

WB 956

1991
OPLS 644

9

ACCESSORIES : DESCRIBE NEW BT'S WITNESS OBJECTS ETC. ESTABLISHED, OR WORK DONE TO PRESERVE EXISTING EVIDENCE

New BTs:

A 16 inch diam. Ponderosa Pine bears N32°E, 91.22 feet marked WB 956 BT
A 18 inch diam. Douglas Fir bears S86°E, 50.15 feet marked WB 956 BT

Attached Bearing Tree and Land Survey Monument signs to the BTs
Set a steel fencepost approximately 5 feet Westerly with
Land Survey Monument and Wilderness Boundary signs attached.

10

Work Done By D.I. Griffith Title Surveyor Date 7-03-91 State Registration No. OPLS 644
or Agency

Certified Cor. Record Prepared? Yes No Filed At: Umatilla Co. Surveyor Off. Date 10-91

11

REMARKS

Witnesses: Jeff Petersen, Jim Bennett and John Osterman

Index File No. WB 956 T.2N

R. 37E

WM.

Tract or Surv. No.


Cor.

12

13

Index
 File No. **CORNER RECORD (SEARCH)** Tract or Survey No. **NF UMATILLA** Cor. No. **AP-956**
 (Ref. FSM 7151.4)
 T. 2 N. R. 37 E. R.D. WALLA-WALLA County UMATILLA
 Merid. WILLAMETTE N.F. UMATILLA State OREGON

CORNER DIAGRAM

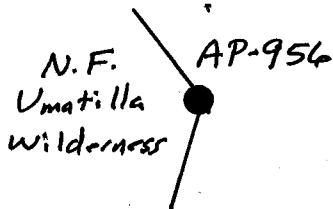

DESCRIBE CORNER MONUMENT FOUND

Found a 2 1/2" aluminum pipe, with a 2 1/2" aluminum cap, projecting 4" out of the ground, mkd. "WILDERNESS BOUNDARY ELEV 4600 WB 956 1991 OPLS 644".

DESCRIBE BEARING TREES OR OTHER OFFICIAL ACCESSORIES FOUND

16" Ponderosa Pine, N. 32° E., 91.2 ft., scribing "WB 956""BT" visible on partially healed double blaze.
 19" Douglas Fir, EAST, 50.2 ft., scribing "WB 956""BT" visible on partially healed double blaze.

PHOTO IDENTIFICATION DATA

Photo No.:
 Filed At.:
 Object Ident.:
 Ident. By:

The BT's have a 3/4" brass washer mkd. "OPLS 644" nailed to the lower blaze by the

DESCRIBE CORNER RELATIVE TO NEAR-BY FEATURES, ALSO HOW TO REACH CORNER

The corner is located on a ridge at an elevation of 4600 feet.

Signature

PLANE COORDINATE POSITION DATA

State: OREGON Zone: NORTH
 X: 2,599,902.80'
 Y: 742,069.16'
 Datum: NAD1927

Signature
D. Schlaich

Title
Land Surveyor

Division

Headquarters
S.O.

Date
11/1993

FS-7100-52 (3/68)

CORNER RECORD (PERPETUATION)

MONUMENT: DESCRIBE NEW MONUMENT SET, OR WORK DONE TO PRESERVE EXISTING MONUMENT

ACCESSORIES : DESCRIBE NEW BT's WITNESS OBJECTS ETC. ESTABLISHED, OR WORK DONE TO PRESERVE EXISTING EVIDENCE

Work Done By **D. Schlaich**

Title **Land Surveyor**

Date **11/1993**

State Registration No.
or Agency

Certified Cor. Record Prepared ? **NO**

Filed At:

Date

REMARKS

Index File No.

T.

2 N.

R.

37 E.

M.

W.M.

Tract or Survey No.

NF UMATILLA

Cor.

AP-956