

Form 874-9—Revised May, 1918  
U. S. Department of Agriculture  
FOREST SERVICE

C  
O  
P  
Y



Umatilla NATIONAL FOREST

CORNERS OF THE PUBLIC SURVEY

T. 2 N R. 37 & 38 E W Mer.  
 $\frac{1}{4}$  Section Corner common to Sections

13, and 18  
Corner consists of a Mound of Rock (not) in place  
State condition Fair

Dimensions above ground 12 inches.  
Sketch grooves, letters, figures, or notches, on proper face or edge.

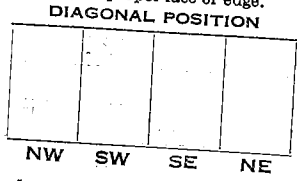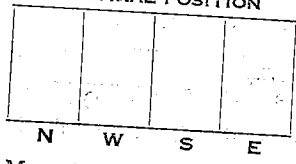

Mound of \_\_\_\_\_ is located \_\_\_\_\_

Pits are located \_\_\_\_\_  
Sketch markings of Bearing Trees (or Rocks) in proper box and fill blanks below, giving bearings from Corner to Trees and Distances in Links.

Over-grown		$\frac{1}{4}$ S	
		BT	

Species DF YP  
Diameter 24" 20"  
Bearing N49W S77E  
Distance 50 lks 60 lks

Do you believe this to be a genuine Land Office Corner? Yes  
If not, why? \_\_\_\_\_

/s/ F. D. Monroe


(Signature)  
J. F.

8/8/31  
(Date)

(Title)

T. 2 N R. 37 & 38 E W Mer.

(Make sketch of topography near Corner)

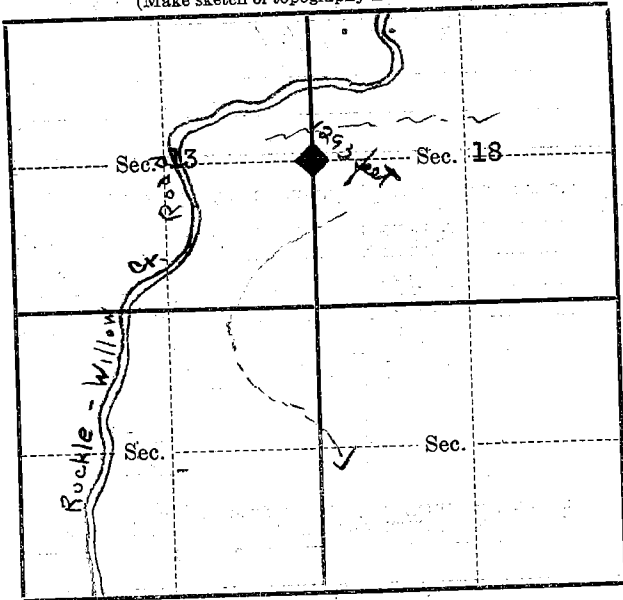

Metal Location Poster is on a YP  
tree 20 inches diameter, on the NW  
side of tree  
from which this Corner bears N60W  
60 links ~~chains~~ distant.

Give any further facts which will aid in finding this  
Corner again.

Corner is found on a fairly steep <sup>or</sup>  
rocky point surrounded by mixed timber  
type. A draw is 4 chains north of cor-  
ner. A section line sign board and  
cruiser tag have been placed on road  
1293 feet north of corner on south side  
of road.