

**OREGON CORNER RESTORATION FORM**

Section 3 Township 2S Range 31E  
 County Umatilla Date: April 8, 2011

Corner Designation: 2S31E13

Corner to sections 3, 4, 9, and 10, T2S, R31E,  
 W.M., Umatilla County, Oregon.


Condition Report Only  
 Not found  
 Remonumented  
 Unrecorded  
 Surveyed in  
 Referenced out

Previous Renewals / Surveys, etc.


Corner originally set by Daniel Chaplin under contract No. 107 dated September 21, 1864. His record reads: Set stone 16x8x6 for Cor. to Secs. 3, 4, 9 & 10

Monument and Accessories found: ( condition and source )

I found a basalt stone, 16x7x5 inches with three notches on the east face, in place in a north south fence line. The stone is in line with an ancient row of rock jacks running east and is 33 feet north of the current fence that runs to the east.

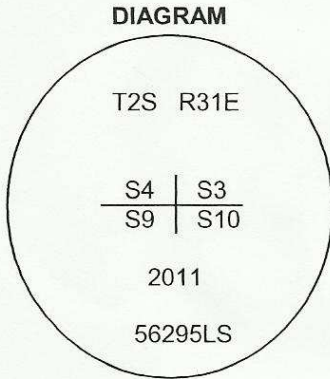

⊗ = Brass Cap  
 ● = Rebar Reference

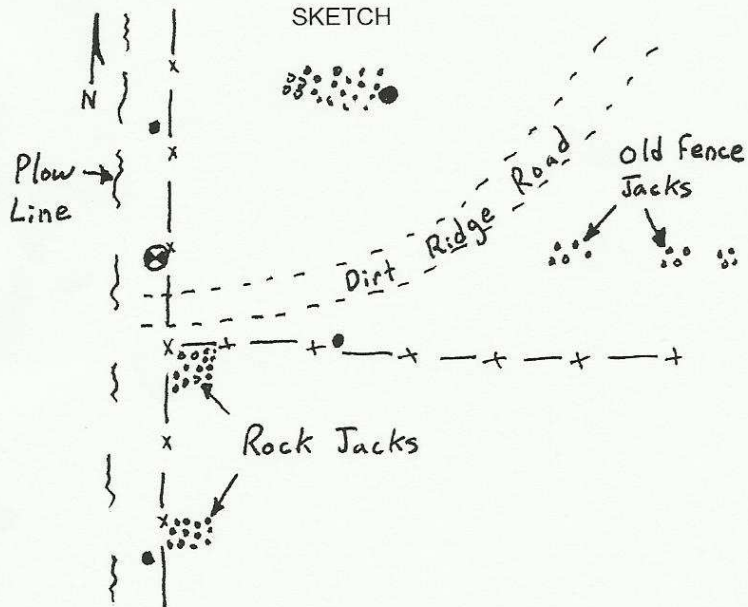

**MONUMENT (S) AND ACCESSORIES SET (Procedures and Description)**

I set a 1 1/2" x 30" galvanized iron pipe with a 2 1/4" brass cap stamped as shown in the diagram above at the position of the original stone.

For references, I set four, 5/8" by 24" rebars with 1 1/8" orange plastic caps attached, stamped WTS and 56295LS as described below:

- an iron rebar bears N23°34'29"E, 95.41 feet in the east end of a mound of field stones;
- an iron rebar bears N1°11'08"E, 35.28 feet under the existing fence running north;
- an iron rebar bears S55°52'51"E, 61.45 feet under an existing fence running east;
- an iron rebar bears S00°42'20"E, 54.26 feet under an existing fence running south;

The monument and references were tied using a Trimble R7/R8 RTK GPS.

Location and comments

Compass Declination

Surveyors Seal

RECEIVED BY:  
Umatilla County Surveyor  
 Date: \_\_\_\_\_  
 Rec'd By: \_\_\_\_\_  
 No. 11-112-C

Firm / Agency  
 Witness Tree Surveying  
 Address  
 P.O. Box G  
 Pilot Rock, Or. 97868  
 Party Chief  
 Stephen K, Haddock

REGISTERED  
 PROFESSIONAL  
 LAND SURVEYOR

*Stephen K. Haddock*

OREGON  
 JULY 9, 2001  
 STEPHEN K. HADDOCK  
 56295LS

RENEWAL DATE 6-30-13