


History of original corner establishment:


The original corner was established by Daniel Chaplin on November 18, 1864, under GLO contract No. 107, as follows:

Set stone 16" x 10" x 6" for 1/4 section corner.

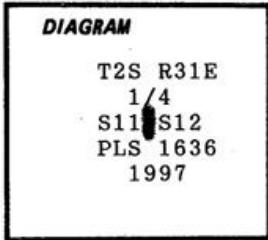

Description of corner evidence found:

The original corner stone is set solidly in a mound of stones. The corner stone is 18" x 12" x 6" and is plainly marked "1/4" on the west face. The corner is in a fence line projecting east and west.

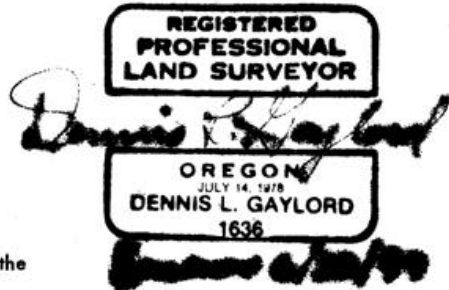

Description of monument and accessories I established to perpetuate the original location of this corner:

In place of the corner stone, I set a 1" x 30" iron pipe 25" into the ground. A 2 1/2" brass cap attached is marked as shown in the diagram above. I bury the corner stone along the west side of the pipe and build a mound of stones around the pipe to the cap, from which:

A 5/8" x 36" iron rod, set 35" into the ground with a 3/4" brass washer, marked "PLS 1636 S12 NE", attached at ground level, bears N49°E, 122.4 feet. This reference is north of a small draw flowing N65°W.

A 5/8" x 36" iron rod, set 31" into the ground with a 3/4" brass washer, marked "PLS 1636 S12 SE", attached at ground level, bears S53°30' E, 110.0 feet.

A 5/8" x 24" iron rod, set 23" into the ground with a 3/4" brass washer, marked "PLS 1636 S11 SW", attached at ground level, bears S4°30'W, 104.5 feet.

A 5/8" x 24" iron rod, set 23" into the ground with a 3/4" brass washer, marked "PLS 1636 S11 NW", attached at ground level, bears N40°30'W, 72.9 feet.

I hereby certify the above corner point was perpetuated as hereon described on June 9, 1997. Magnetic declination: 20° E.

Office of _____ County of _____
State of _____, I hereby certify that the within instrument was filed in this office for record on the _____ day of _____, 19_____

(COUNTY OFFICIAL)

RECEIVED BY


Date: 6-97
Rec'd by: RR
No. 97-116-R