

OREGON CORNER RECORPORATION FORM

Section 4 Township 2S Range 32E
 County Umatilla Date: April 25, 1997

Corner Designation: 2S32 E9

Corner to sections 4, 5, 8, and 9 T2S, R32E W.M.



Condition Report Only
 Not found
 x Remonumented
 Unrecorded
 Surveyed in
 x Referenced out

Previous Renewals / Surveys, etc.

Corner originally set by David P. Thompson under contract No. 106 Dated August 16, 1864.
 His record reads: Set post for corner to sections 4, 5, 8, and 9, in mound of stone.

Monument and Accessories found: (condition and source)

A stone 20 x 10 x 8 inches with an "X" on top was found buried vertically in a mound of stone at the remains of an old fence intersection with fences running North, South, and West. There is no wire left in the fence but there are numerous old fence posts laying along the fence lines.

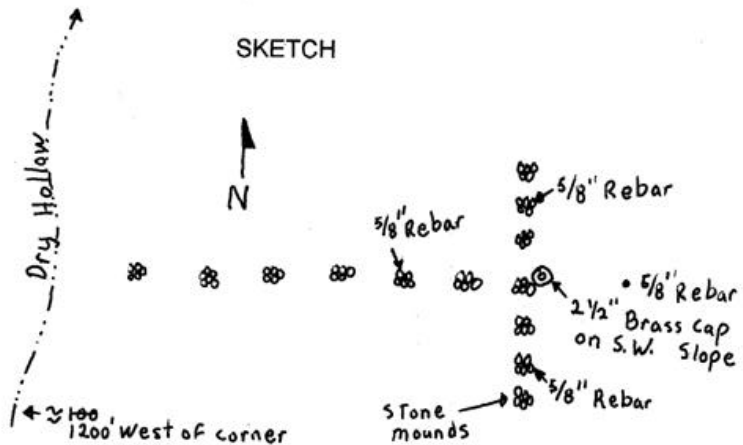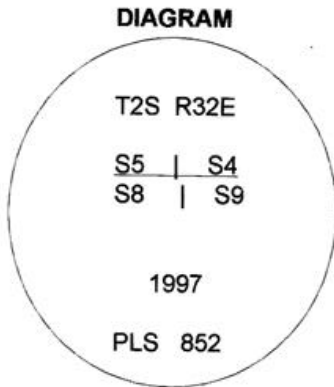

MONUMENT (S) AND ACCESSORIES SET (Procedures and Description)

Set a 1 1/4" x 30" Galvanized Iron Pipe with a 2 1/2" brass cap stamped as shown in the diagram above at the position of the stone. Raised a mound of stone around the monument.

For references, I set four 5/8" by 24" rebars with 1.25" red plastic caps stamped ORLS 852 and WAL5 13922 as described below:

- a rebar bears N0°04'E, 36.09 feet in a mound of stone;
- a rebar bears S88°54'E, 41.55 feet;
- a rebar bears S0°12'E, 25.39 feet in a mound of stone;
- a rebar bears N87°07'W, 34.08 feet in a mound of stone;

Monument and reference locations were surveyed with GPS receivers in stop and go mode.

The bearings are true. The distances are grid.

Location and comments

Compass Declination

Surveyors Seal

RECEIVED BY:
Umatilla County Surveyor
 Date: 7-97
 Rec'd By: KK
 No. 97-134-B

Firm / Agency
 Haddock Surveying
 Address
 P.O. Box 1574
 Pendleton, Or. 97801
 Party Chief
 Stephen K, Haddock

REGISTERED
 PROFESSIONAL
 LAND SURVEYOR

David L. Haddock

OREGON
 JULY 12, 1968
 DAVID L. HADDOCK
 852

RECEIVED BY
Umatilla County Surveyor
 Date _____
 Rec'd By _____
 No. _____

Refer to 97-109-B