

OREGON CORNER RESTORATION FORM

Section 29 Township 2S Range 32E
 County Umatilla Date: March 29, 2007

Corner Designation: 2S32R7

Condition Report Only
 Not found
 Remonumented
 Unrecorded
 Surveyed in
 Referenced out


Quarter corner common to sections 20 and 29, T2S, R32E,
 W.M., Umatilla County, Oregon.

Previous Renewals / Surveys, etc.


Corner originally set by Daniel Chaplin under contract No. 107 dated September 21, 1864. His record reads: Set stone, 16 x 12 x 10, for 1/4 sec. Cor.

Monument and Accessories found: (condition and source)

I found a record dimension basalt stone with approximately 1" exposed at the corner of a long term possessory fence with fences running south and east. The stone was unmarked.

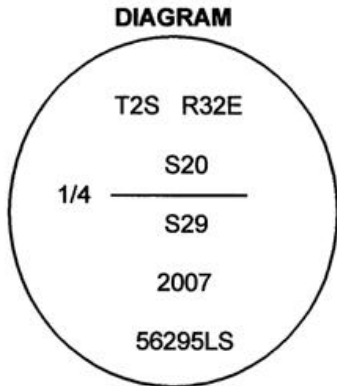

⊙ = Brass Cap
 ● = Rebar Reference

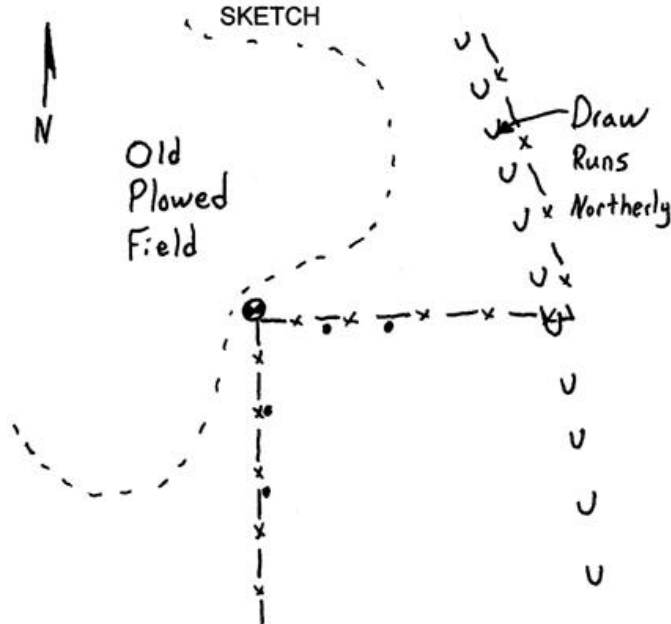

MONUMENT (S) AND ACCESSORIES SET (Procedures and Description)

At the position of the original stone I set a 1 1/2" x 30" galvanized iron pipe with a 2 1/4" brass cap attached stamped as shown in the diagram above.

For references, I set four 5/8" by 24" rebars with 1.25" orange plastic caps stamped WTS and 56295LS under the existing fences as described below:

- an iron rebar bears S1°11'48"E, 33.85 feet;
- an iron rebar bears S0°18'42"E, 63.19 feet;
- an iron rebar bears N78°49'00"E, 31.55 feet;
- an iron rebar bears N80°19'51"E, 58.57 feet;
- A 3" aluminum cap marked USFS GPS station "SALT" bears N74°32'18"W, 1188.85 feet.

The monument and references were tied using a Trimble R7/R8 RTK GPS.

Location and comments

Compass Declination

Surveyors Seal

RECEIVED BY:
Umatilla County Surveyor
 Date: 6-07
 Rec'd By: KE
 No. 07-169-C

Firm / Agency
 Witness Tree Surveying
 Address
 P.O. Box G
 Pilot Rock, Or. 97868
 Party Chief
 Stephen K, Haddock

REGISTERED
 PROFESSIONAL
 LAND SURVEYOR

Stephen K. Haddock

OREGON
 JULY 9, 2001
 STEPHEN K. HADDOCK
 56295LS

RENEWAL DATE 6-30-07