

Index
File No. Z-19
T 2S R. 32E
Merid. WILLAMETTE


CORNER RECORD (SEARCH)

(Ref. FSM 7151.4)

Tract or
Survey No. _____ Cor.
No. _____

R.D. NORTH FORK J.D. County UMATILLA
N.F. UMATILLA State OREGON

CORNER DIAGRAM

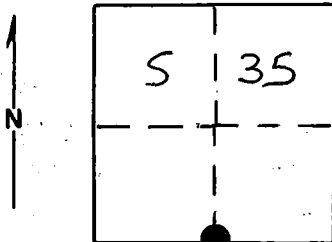

DESCRIBE CORNER MONUMENT FOUND

Found a stone 14x10x5 inches set 7" in the ground marked $\frac{1}{4}$

DESCRIBE BEARING TREES OR OTHER OFFICIAL ACCESSORIES FOUND

A 18 inch diameter Western Larch bears South, 9 lks, sawn 6 ft. above ground with scribes visible. A root hole bears N18°W, 5 lks.

PHOTO IDENTIFICATION DATA

Photo No. 1687-43
Filed At. Ranger Office
Object Ident. As shown
Ident. By D.I. Griffith
Signature

DESCRIBE CORNER LOCATION RELATIVE TO NEAR-BY FEATURES, ALSO HOW TO REACH CORNER

Corner falls on brushy timbered West slope approximately 15 feet East of a draw and 800 feet West of the road at the gate.

PLANE COORDINATE POSITION DATA

State _____ Zone _____
X _____
Y _____
Estab. By _____
Agency

Signature _____ Title _____ Division _____ Headquarters _____ Date 9-7-88 FS-7100-52 (3/68)

Signature SURVEYOR

CORNER RECORD (PERPETUATION)

MONUMENT: DESCRIBE NEW MONUMENT SET, OR WORK DONE TO PRESERVE EXISTING MONUMENT

Set a 2½"x30" aluminum pipe with aluminum cap marked as shown:
Pipe is set 28 inches in the ground.

T2S R32E
¼ S 35

Raised a small mound of stone around monument.
Buried the original corner stone South and alongside of monument.

T3S R32E
1988
OPLS 644

ACCESSORIES : DESCRIBE NEW BT'S WITNESS OBJECTS ETC. ESTABLISHED, OR WORK DONE TO PRESERVE EXISTING EVIDENCE

New BTs:

A 10 inch diameter Douglas Fir bears N22°E, 70.24 feet marked ¼ S35 BT
A 5 inch diameter Lodgepole Pine bears N60°W, 15.3 feet marked X BT

Painted a 6 inch red band around all bearing trees and attached 54-3 and 54-9 signs.

Set a steel fencepost 3.93 feet East with 54-9 sign attached.

Work Done By D.I. Griffith Title Surveyor Date 8-24-88 State Registration No. OPLS 644
or Agency

Certified Cor. Record Prepared ? Yes No Filed At: Umatilla County Surveyor Office Date 10-88

REMARKS

Witnesses: Rick Robinson and Jeff Petersen

Index File No. Z-19 T.25 R.32E WM. Tract or Surv. No. Cor.

USDA-FOREST SERVICE

Index File No. Z-19
T 25 R. 32E
Merid. WILL


CORNER RECORD (SEARCH)

(Ref. FSM 7151.4)

Tract or Survey No. _____ Cor. No. _____

R.D. NORTH FORK County UMATILLA
N.F. UMATILLA State OREGON

CORNER DIAGRAM

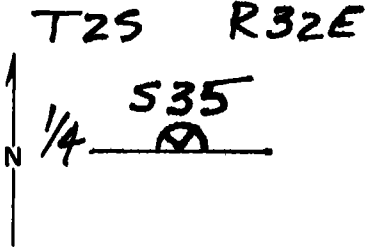

DESCRIBE CORNER MONUMENT FOUND

STONE IN PLACE PLAINLY MARKED " $\frac{1}{4}$ "
ON NORTH FACE. STONE IS A BIT
SMALLER THAN RECORD SIZE.

DESCRIBE BEARING TREES OR OTHER OFFICIAL ACCESSORIES FOUND

HIGH STUMPED W. LARCH WITH SOME SCRIBES
VISIBLE BEARS SOUTH, 5.9ft. DOUBLE BLAZES
ARE NEARLY HEALED OVER. NO TRACE OF
RECORD B.T. TO N.W. A VALSETZ LMBR CO.
LOCATION POSTER IS ON A 8" FIR 4 FT. NORTH OF
CORNER.

PHOTO IDENTIFICATION DATA

Photo No. _____
Filed At. _____
Object Ident. _____
Ident. By _____
Signature _____

DESCRIBE CORNER LOCATION RELATIVE TO NEAR-BY FEATURES, ALSO HOW TO REACH CORNER

CORNER IS 15 FT. EAST OF A SMALL DRAW
AND 200 FT. SOUTH OF AN EAST-WEST
FENCE.

PLANE COORDINATE POSITION DATA

State _____ Zone _____
X _____
Y _____
Estab. By _____
Agency _____

Signature _____ Title _____ Division _____ Headquarters _____ Date _____

Dennis L. Gaylord L.S. 1636 4-20-88

CORNER RECORD (PERPETUATION)

MONUMENT : DESCRIBE NEW MONUMENT SET, OR WORK DONE TO PRESERVE EXISTING MONUMENT

ACCESSORIES : DESCRIBE NEW BT'S WITNESS OBJECTS ETC. ESTABLISHED, OR WORK DONE TO PRESERVE EXISTING EVIDENCE

Work Done By _____ Title _____ Date _____ State Registration No. _____
or Agency _____

Certified Cor. Record Prepared ? Yes No Filed At: _____ Date _____

REMARKS

Index File No. T. R. M. Tract or Surv. No. Cor.