

OREGON CORNER REFORMATION FORM

Section 32 Township 2S Range 32E
 County Umatilla Date: July 8, 2009

Corner Designation: 2S32Z7

South One Quarter corner to only section 32, T2S, R32E,
 W.M., Umatilla County, Oregon.



Condition Report Only
 Not found
 Remonumented
 Unrecorded
 Surveyed in
 Referenced out

Previous Renewals / Surveys, etc.


This corner was first set by David P. Thompson under contract No. 106 dated August 16, 1864. His record reads: Set stone 16x8x6 ins for 1/4 Sec. Cor.; This corner was later superceded by George S. Pershin under contract No. 430 dated March 23, 1882. His record reads: Can find no trace of old corner. Set a basalt stone, 17x8x7, 12 ins. in ground on N.W. slope for 1/4 Sec. Cor., marked 1/4 on N. Face, raised mound of stone along side.

Monument and Accessories found: (condition and source)

None. The corner falls about 30 feet south of the creek at the toe of a steep north slope. Different ages of stumps indicate that this area has been logged at least three times.

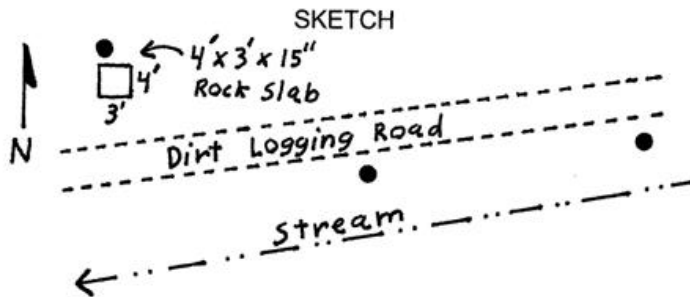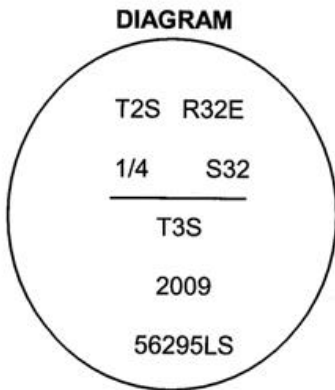

- ⊙ = Brass Cap
- = Rebar Reference
- = Guard Post w/Mon Sign

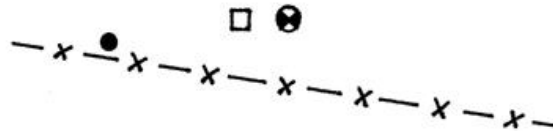

MONUMENT (S) AND ACCESSORIES SET (Procedures and Description)

At the proportioned point, I set a 1 1/2" x 30" galvanized iron pipe with a 2 1/4" brass cap attached stamped as shown in the diagram above.

For references, I set four 5/8" by 24" rebars with 1.25" orange plastic caps stamped WTS and 56295LS as described below:

- an iron rebar bears S69°46'37"W, 59.13 feet;
- an iron rebar bears N56°36'20"W, 178.38 feet;
- an iron rebar bears N21°54'12"W, 119.53 feet;
- an iron rebar bears N13°43'16"E, 145.67 feet;

The monument and references were tied using a Trimble R7/R8 RTK GPS.

Location and comments

Compass Declination

Surveyors Seal

RECEIVED BY:
Umatilla County Surveyor
 Date: 9-09
 Rec'd By: KK
 No. 09-124-B

Firm / Agency
 Witness Tree Surveying
 Address
 P.O. Box G
 Pilot Rock, Or. 97868
 Party Chief
 Stephen K, Haddock

REGISTERED
 PROFESSIONAL
 LAND SURVEYOR

Stephen K. Haddock

OREGON
 JULY 9, 2001
 STEPHEN K. HADDOCK
 56295LS

RENEWAL DATE 6-30-11