

OREGON CORNER RESTORATION FORM

Section 6 Township 2S Range 33E
 County Umatilla Date: April 13, 2001

Corner Designation: 2S33E1

West corner to sections 6 and 7, T2S, R33E,
 W.M., Umatilla County, Oregon.


Condition Report Only
 Not found
 Remonumented
 Unrecorded
 Surveyed in
 Referenced out

Previous Renewals / Surveys, etc.

Corner originally set by David P. Thompson under contract #551 dated March 19, 1890.
 His record reads: Set a basalt stone, 26 x 10 x 8 ins., 20 ins. in ground, for Closing Cor. to
 Secs. 6 abd 7, marked 1 notch on N. and 5 notches on S and C.C. on W.; dug pits 18 x 18 x 12
 ins. N., S., and E. of stone 5 1/2' dist.. Raised mound of stone and earth, 2 ft. high x 4 1/2 ft. base
 over Cor., on E. hillside.

Monument and Accessories found: (condition and source)

The original stone, plainly chisled, lying loose on the hillside below the mound. The stones
 position in a small pile of rocks was still apparent.

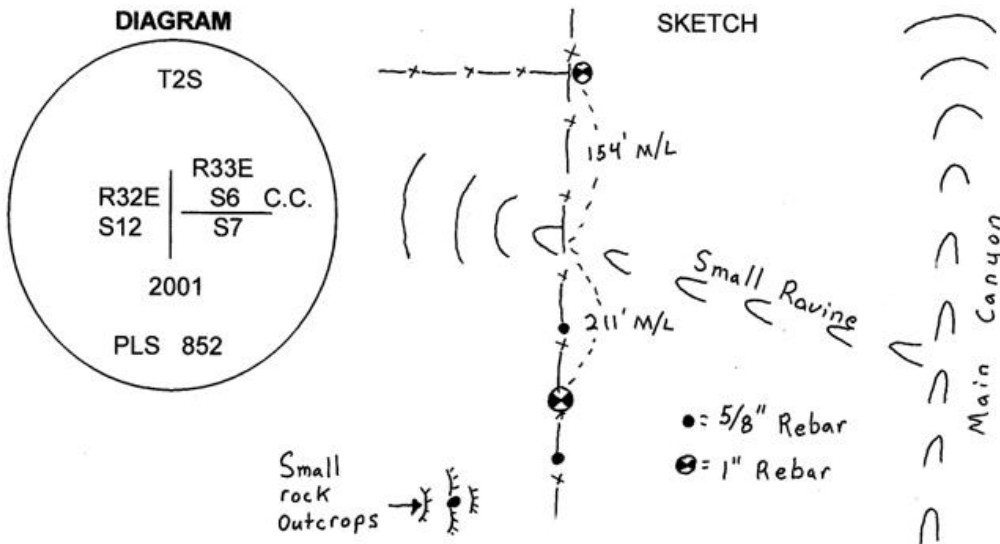

MONUMENT (S) AND ACCESSORIES SET (Procedures and Description)

I set a 1" x 24" iron rebar with a 2" aluminum cap stamped as shown in the diagram above in
 the center of the original mound. I burried the stone along side.

For references, I set three, 5/8" by 24" rebars with 1.25" red plastic caps stamped ORLS 852 and
 WALS 13922 as described below:

- an iron rebar bears N00°13'42"W, 40.31 feet in the existing fence;
- an iron rebar bears S01°08'44"W, 55.56 feet in the existing fence;
- an iron rebar bears S17°43'16"W, 154.06 feet in a small rock outcrop;
- A 1" x 24" iron rebar monumenting the corner to sections 1 and 12, T2S, R33E, W.M. bears
 N00°05'33"E, 364.85 feet at the corner of fences N., S., and W.;

The monument and references were tied using a Trimble 4700 RTK GPS.


Location and comments
 Witnessed by Troy S. Laws
 ODF&W

Compass Declination

Surveyors Seal

RECEIVED BY:
Umatilla County Surveyor
 Date: _____
 Rec'd By: _____
 No. 01-66-B

Firm / Agency
 Haddock Surveying
 Address
 P.O. Box 1574
 Pendleton, Or. 97801
 Party Chief
 Stephen K, Haddock

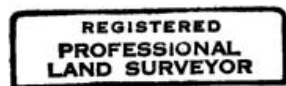

David L. Haddock



Renews 6-30-01