

**OREGON CORNER RESTORATION FORM**

Section 24 Township 2S Range 33E  
 County Umatilla Date: June 14, 2000

Corner Designation: 2S33P21

Common quarter corner to sections 23 and 24, T2S, R33E, W.M., Umatilla County, Oregon.

Condition Report Only  
 Not found  
 Remonumented  
 Unrecorded  
 Surveyed in  
 Referenced out


Previous Renewals / Surveys, etc.

Corner originally set by John C. Arnold under contract #551 dated March 19, 1890.

His record reads: Set basalt stone, 18 x 18 x 6 ins., 12 ins. in ground for 1/4 section cor. marked 1/4 on W. face, raised a mound of stone 2 ft. high by 4 ft. base over corner.

Monument and Accessories found: ( condition and source )

The original stone, lying loose below the record mound. There was a divot in the mound where the stone had been.

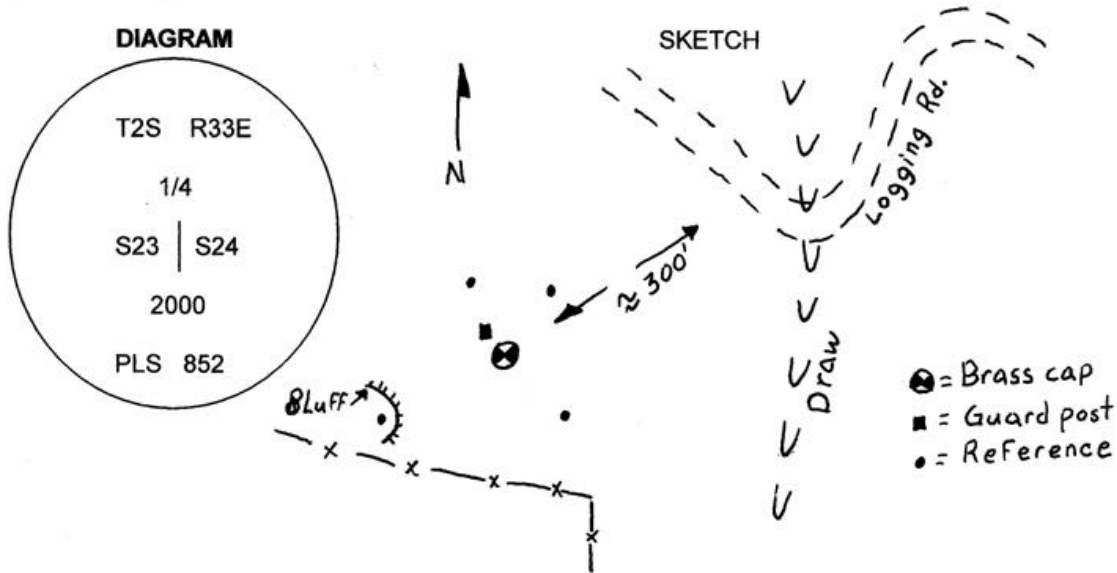

**MONUMENT (S) AND ACCESSORIES SET (Procedures and Description)**

Set a 1 1/2" x 30" galvanized iron pipe with a 2 1/4" brass cap stamped as shown in the diagram above at the position of the original stone. Buried the stone along side. Set a 6' steel post with a county monument sign attached along side.

For references, I set four 5/8" by 24" rebars with 2.5" red plastic caps stamped ORLS 852, WALSH 13922 and HADDOCK SURVEYING as described below:

- an iron rebar bears N29°47'47"W, 32.65 feet;
- an iron rebar bears N39°03'56"E, 24.36 feet;
- an iron rebar bears S50°33'01"W, 68.12 feet in the top of a small bluff;
- an iron rebar bears S42°11'27"E, 65.27 feet;

The monument and references were tied using a LIECA system 300 RTK GPS.

Location and comments

Compass Declination

Surveyors Seal

RECEIVED BY:  
 Umatilla County Surveyor  
 Date: 7-00  
 Rec'd By: KE  
 No. 00-156-B

Firm / Agency  
 Haddock Surveying  
 Address  
 P.O. Box 1574  
 Pendleton, Or. 97801  
 Party Chief  
 Stephen K, Haddock

REGISTERED  
 PROFESSIONAL  
 LAND SURVEYOR

*David L. Haddock*

OREGON  
 JULY 12, 1988  
 DAVID L. HADDOCK  
 852