

**OREGON CORNER RESTORATION FORM**

Section 28 Township 2S Range 33E  
 County Umatilla Date: June 20, 2000

Corner Designation: 2S33T13

Common quarter corner to sections 27 and 28, T2S, R33E, W.M., Umatilla County, Oregon.


Condition Report Only  
 Not found  
 Remonumented  
 Unrecorded  
 Surveyed in  
 Referenced out

Previous Renewals / Surveys, etc.

Corner originally set by John C. Arnold under contract #551 dated March 19, 1890.  
 His record reads: Set basalt stone, 16 x 10 x 6 ins., 12 ins. in ground for 1/4 section cor. marked 1/4 on W. face, raised a mound of stone 2 ft. high by 4 1/2 ft. base over stone, from which:  
 A fir, 12 ins, diam., brs. E. 100 lks., marked 1/4 S BT.

Monument and Accessories found: ( condition and source )

None. The point falls in the drag tracks below a high lead logging landing. The ground had logging debris in the top 3 feet of soil.

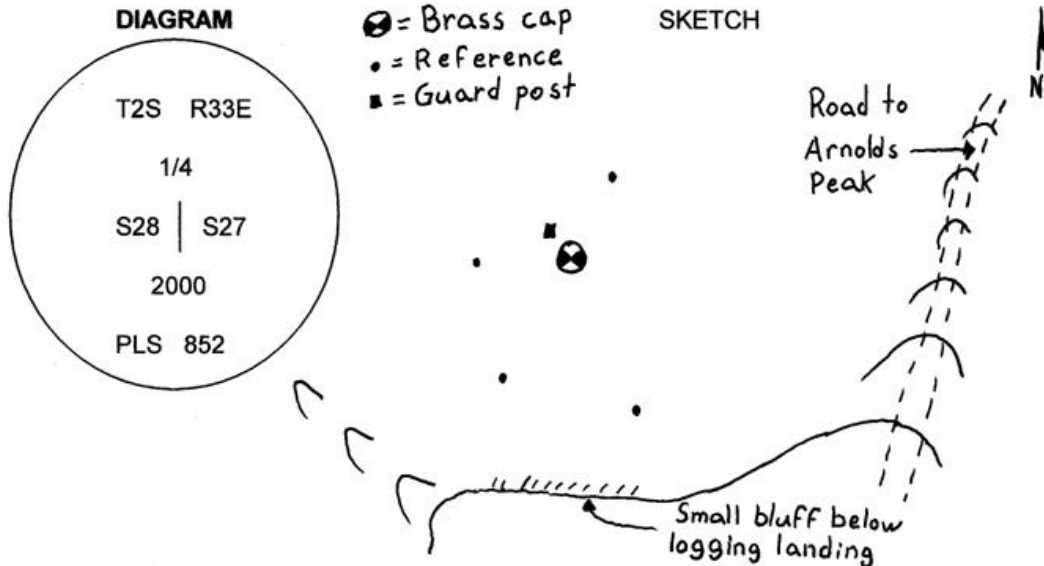

MONUMENT (S) AND ACCESSORIES SET (Procedures and Description)

Set a 1 1/2" x 30" galvanized iron pipe with a 2 1/4" brass cap stamped as shown in the diagram above at the proportional point. Set a 6' steel post with a county monument sign attached along side.

For references, I set four 5/8" by 24" rebars with 2.5" red plastic caps stamped ORLS 852, WAL5 13922 and HADDOCK SURVEYING as described below:

- an iron rebar bears S88°47'50"W, 23.77 feet;
- an iron rebar bears N24°20'13"E, 19.99 feet;
- an iron rebar bears S19°17'49"W, 42.17 feet;
- an iron rebar bears S30°31'12"E, 60.35 feet;

The monument and references were tied using a LIECA system 300 RTK GPS.

Location and comments

Compass Declination

Surveyors Seal

RECEIVED BY:  
 Umatilla County Surveyor  
 Date: 7-00  
 Rec'd By: KK  
 No. 00-756-C

Firm / Agency  
 Haddock Surveying  
 Address  
 P.O. Box 1574  
 Pendleton, Or. 97801  
 Party Chief  
 Stephen K, Haddock

REGISTERED  
 PROFESSIONAL  
 LAND SURVEYOR

*David L. Haddock*

OREGON  
 JULY 12, 1988  
 DAVID L. HADDOCK  
 852