



OREGON CORNER RESTORATION FORM

Section 25 Township 2S Range 33E
 County Umatilla Date: April 18, 2000

Corner Designation: 2S33T25 Condition Report Only
 Not found
 East quarter corner to section 25, T2S, R33E, W.M., Umatilla County, Oregon. x Remonumented
 Unrecorded
 Surveyed in
x Referenced out

Previous Renewals / Surveys, etc.
 Corner originally set by James P. Currin and James E. Noland under special contract dated May 4, 1887. Their record reads: Set post, 36x3x3 ins., 2 ft. in ground, for 1/4 sec. cor. marked 1/4 S. on W. face, from which:
 A pine, 16 ins. diam., brs. S56°E, 2 lks. dist., marked 1/4 S., B.T.
 A pine, 20 ins. diam., brs. N70°W, 32 lks. dist., marked 1/4 S., B.T.
 References to Range 34 East were removed and the letters UR added to the east side of the monuments for the Umatilla Reservation Boundary under the same contract.

Monument and Accessories found: (condition and source)
 Found a badly decayed pine snag with a location poster dated 1940. Found a stump hole with pine roots. The decayed snag had been dozed out during logging. The position falls within 6 feet of the proportional location based on verified corners to the north and south.

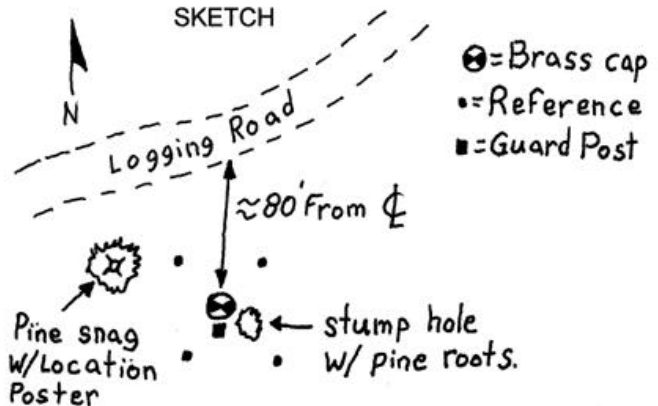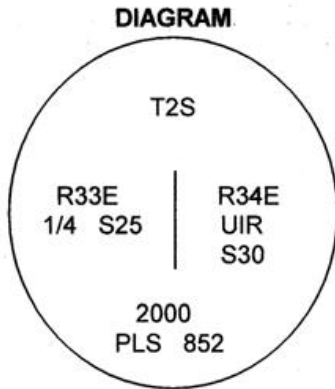

MONUMENT (S) AND ACCESSORIES SET (Procedures and Description)
 Set a 1 1/4" x 30" Galvanized Iron Pipe with a 2 1/2" brass cap stamped as shown in the diagram above at the correct distances from the remains of the bearing trees. Set a 6' steel post with a county monument sign along side.

For references, I set four 5/8" by 24" rebars with 1.25" red plastic caps stamped ORLS 852 and WALS 13922 as described below:
 an iron rebar bears N44°13'11"W, 24.70 feet;
 an iron rebar bears N56°23'01"E, 23.95 feet;
 an iron rebar bears S45°59'53"W, 26.14 feet;
 an iron rebar bears S40°58'49"E, 27.24 feet;

The monument and references were tied using a LIECA system 300 RTK GPS.

Location and comments Compass Declination Surveyors Seal

RECEIVED BY:
Umatilla County Surveyor
 Date: 7-00
 Rec'd By: [Signature]
 No. 00C156-C

Firm / Agency
 Haddock Surveying
 Address
 P.O. Box 1574
 Pendleton, Or. 97801
 Party Chief
 Stephen K, Haddock

