

**OREGON CORNER RESTORATION FORM**

Section 25 Township 2S Range 33E  
 County Umatilla Date: April 26, 2000

Corner Designation: 2S33V21

Corner to sections 25, 26, 35, and 36, T2S, R33E,  
 W.M., Umatilla County, Oregon.

Condition Report Only  
 Not found  
 Remonumented  
 Unrecorded  
 Surveyed in  
 Referenced out

Previous Renewals / Surveys, etc.

Corner originally set by John C. Arnold under contract #551 dated March 19, 1890.

His record reads: A basalt stone, in place, 18 x 18 x 6 ins. above ground which I mark for Cor. to Secs. 25, 26, 35, and 36, X at Cor. point, with 5 notches on N. edge and 1 notch on E. face. Raise a mound of earth and stone, 2 ft. high x 4 ft. base over the stone, from which:

A pine, 30 ins. diam. brs. N25°E, 241 lks. dist., marked T2S, R33E, S25BT;


A fir, 8 ins. diam. brs. N75°E, 30 lks. dist., marked T2S, R33E, S36BT;

A pine, 50 ins. diam. brs. S65°W, 64 lks. dist., marked T2S, R33E, S35BT;

A fir, 8 ins. diam. brs. N75°W, 58 lks. dist., marked T2S, R33E, S26BT;

Monument and Accessories found: ( condition and source )

A distinct mound of stone with a record dimension stone in place. A divot in the steep hill side is in the right location for the 50" pine. The mound location agrees with the call to the creek and is close to record distance from the W. 1/4 corner of S25 and the SW corner of S36. The area had been heavily logged and also showed signs of fire.

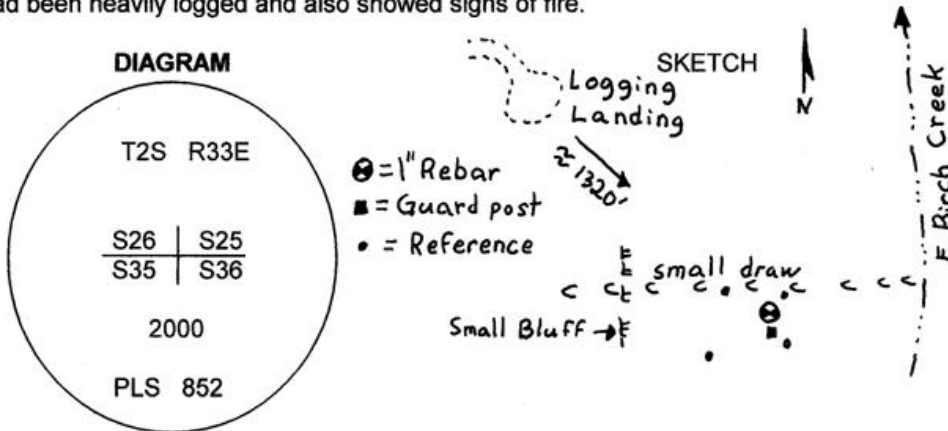

MONUMENT (S) AND ACCESSORIES SET (Procedures and Description)

Set a 1" x 24" Iron Rebar with a 2" Aluminum cap stamped as shown in the diagram above in the original mound. Set a 6' steel post with a county monument sign attached along side.

For references, I set four, 5/8" by 24" rebars with 1.25" red plastic caps stamped ORLS 852 and WAL5 13922 as described below:

an iron rebar bears N28°23'04"W, 34.91feet;

an iron rebar bears N26°41'00"E, 8.20 feet;

an iron rebar bears S55°36'17"W, 40.91feet;

an iron rebar bears S23°39'48"E, 47.38 feet;

The monument and references were tied using a LIECA system 300 RTK GPS.

Location and comments

Compass Declination

Surveyors Seal

RECEIVED BY:

Umatilla County Surveyor

Date: 7-00

Rec'd By: KR

No. 00-156-C

Firm / Agency

Haddock Surveying

Address

P.O. Box 1574

Pendleton, Or. 97801

Party Chief

Stephen K, Haddock

