

**OREGON CORNER RESTORATION FORM**

Section 25 Township 2S Range 33E  
 County Umatilla Date: June 15, 2000

Corner Designation: 2S33V23

Quarter corner to sections 25 and 36, T2S, R33E,  
 W.M., Umatilla County, Oregon.



Condition Report Only  
 Not found  
 Remonumented  
 Unrecorded  
 Surveyed in  
 Referenced out

Previous Renewals / Surveys, etc.

Corner originally set by John C. Arnold under contract No. 551 dated March 19, 1890.  
 His record reads: Set basalt stone 16 x 13 x 13 ins., marked 1/4 on N. face. As digging at this point is impracticable, I made a mound of stone, 4' high x 5, base over the cor. stone on summit of mountain.

Monument and Accessories found: ( condition and source )

None. There is an E - W fence north of the corner point with many rock jacks. The jacks in the area were checked but I did not find the stone. Most stones in this area were flat and thin.

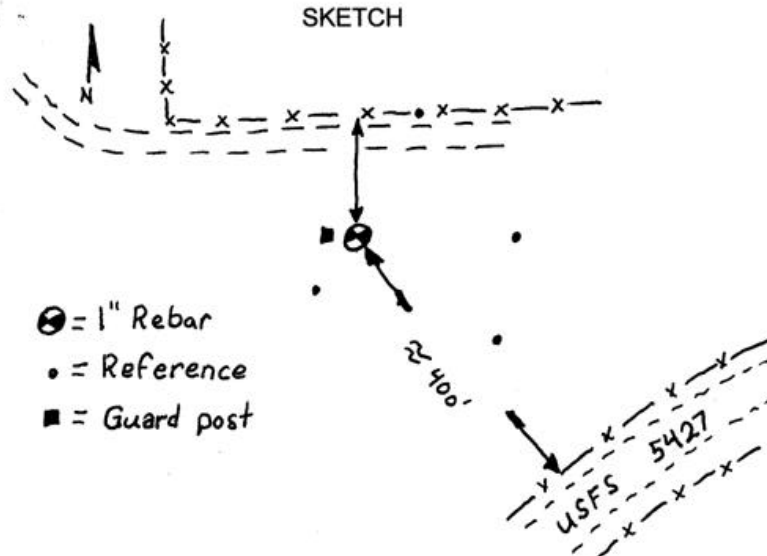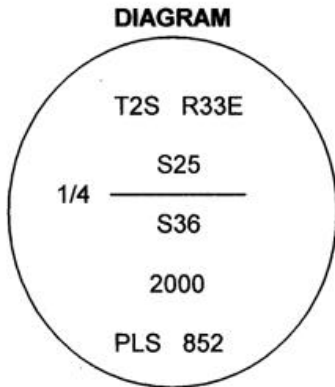

- ⊙ = 1" Rebar
- = Reference
- = Guard post

**MONUMENT (S) AND ACCESSORIES SET (Procedures and Description)**

Set a 1" x 24" Iron rebar with a 2" aluminum cap stamped as shown in the diagram above at the proportionate point. Set a 6' steel post with a county monument sign attached along side.

For references, I set four 5/8" by 24" rebars with 2.5" red plastic caps stamped ORLS 852, WALSH 13922 and HADDOCK SURVEYING as described below:

- an iron rebar bears N32°47'30"E, 43.51 feet in the existing fence;
- an iron rebar bears N83°13'44"E, 64.79 feet;
- an iron rebar bears S43°39'16"E, 108.33 feet;
- an iron rebar bears S48°51'14"W, 28.37 feet;

The monument and references were tied using a LIECA SYSTEM 300 RTK GPS.

Location and comments

Compass Declination

Surveyors Seal

RECEIVED BY:  
 Umatilla County Surveyor  
 Date: 7-00  
 Rec'd By: KK  
 No. 00-156-C

Firm / Agency  
 Haddock Surveying  
 Address  
 P.O. Box 1574  
 Pendleton, Or. 97801  
 Party Chief  
 Stephen K, Haddock



*David L. Haddock*

