

OREGON CORNER RESTORATION FORM

Section 25 Township 2S Range 33E
 County Umatilla Date: April 18, 2000

Corner Designation: 2S33V25

East corner to sections 25 and 36, T2S, R33E,
 W.M., Umatilla County, Oregon.



Condition Report Only
 Not found
 Remonumented
 Unrecorded
 Surveyed in
 Referenced out

Previous Renewals / Surveys, etc.

Corner originally set by James P. Currin and James E. Noland under special contract dated May 4, 1887. Their record reads: Set basalt stone, 12x10x8 ins., 8 ins. in ground, for Cor. to Secs. 25, 30, 31, and 36, marked 1 notch on S. and 5 notches on N. edges from which:
 A pine, 12 ins. diam., brs. N20°E, 133 lks. dist., marked T2S R34E S30 B.T.
 A fir, 14 ins. diam., brs. S52°E, 35 lks. dist., marked S31 B.T.
 A pine, 16 ins. diam., brs. S42°W, 62 lks. dist., marked R33E S36 B.T.
 A pine, 20 ins. diam., brs. N85°W, 96 lks. dist., marked S25 B.T.
 References to Range 34 East were obliterated and the letters UR added for the Reservation Boundary under the same contract.

Monument and Accessories found: (condition and source)

A 31" dbh Fir, plainly scribed, S31°E, 23.1feet; A 31" dbh pine, plainly scribed, S36°W, 40.92 feet;
 A 37" pine, no visible scar, N85°W, 59 feet; A 4 foot steel post driven S9°E 2.1 feet from the corne

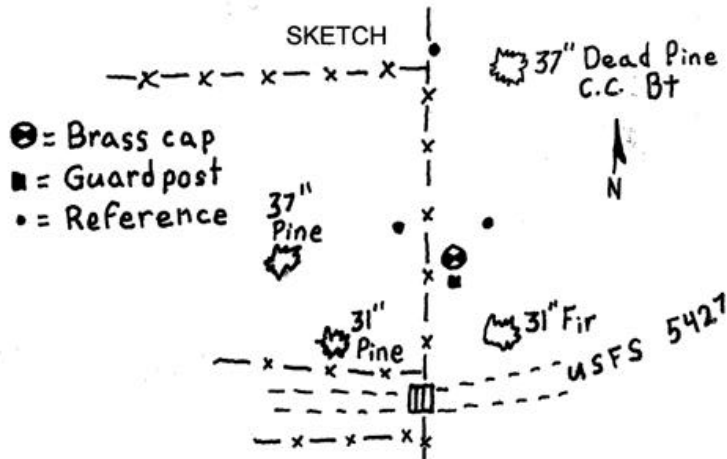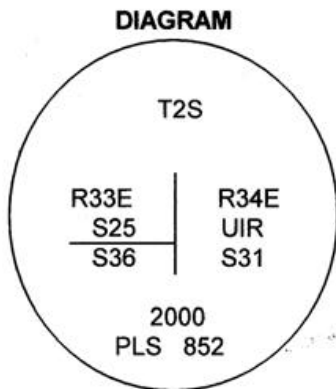

MONUMENT (S) AND ACCESSORIES SET (Procedures and Description)

Set a 1 1/4" x 30" Galvanized Iron Pipe with a 2 1/2" brass cap stamped as shown in the diagram above at the correct distances from the scribed bearing trees. Attached a county monument sign to the existing steel post.

For references, I set three 5/8" by 24" rebars with 1.25" red plastic caps stamped ORLS 852 and WAL5 13922 as described below:

- an iron rebar bears N30°04'01"W, 31.05 feet;
- an iron rebar bears N55°52'22"E, 39.79 feet;
- an iron rebar bears N1°24'34"W, 192.44 feet at the position of the closing corner for sections 19; and 30, Range 34 East, as determined from the dead pine bearing tree for that corner.

The monument and references were tied using a LIECA system 300 RTK GPS.

Location and comments

Compass Declination

Surveyors Seal

RECEIVED BY:
Umatilla County Surveyor
 Date: 7-00
 Rec'd By: KE
 No. 00-156-C

Firm / Agency
 Haddock Surveying
 Address
 P.O. Box 1574
 Pendleton, Or. 97801
 Party Chief
 Stephen K, Haddock

REGISTERED
 PROFESSIONAL
 LAND SURVEYOR

David L. Haddock

OREGON
 JULY 12, 1968
 DAVID L. HADDOCK
 852