

USDA-FOREST SERVICE


Index
File No. X-5
T 2 S 33 E R. 33 E
Merid. Willamette

CORNER RECORD (SEARCH)

(Ref. FSM 7151.4)

Tract or Survey No. _____ Cor. No. 1/4
R.D. Ukiah County Umatilla
N.F. Umatilla State Oregon

CORNER DIAGRAM

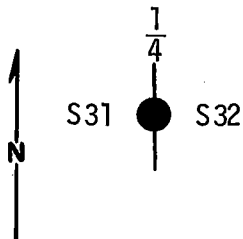

DESCRIBE CORNER MONUMENT FOUND

A diligent search was made and the original corner stone could not be found.

DESCRIBE BEARING TREES OR OTHER OFFICIAL ACCESSORIES FOUND

None was set.

PHOTO IDENTIFICATION DATA

Photo No. _____
Filed At. _____
Object Ident. _____
Ident. By _____
Signature

DESCRIBE CORNER LOCATION RELATIVE TO NEAR-BY FEATURES, ALSO HOW TO REACH CORNER

The corner falls on a very steep, rock and bald south slope.

PLANE COORDINATE POSITION DATA

State _____ Zone _____
X _____
Y _____
Estab. By _____
Agency

Signature

Title

Division
ORLS

Headquarters
1294

Date
9-77

7100-52-(3/68)

CORNER RECORD (PERPETUATION)

MONUMENT: DESCRIBE NEW MONUMENT SET, OR WORK DONE TO PRESERVE EXISTING MONUMENT

At surveyed point set 2 1/2"x30" galvanized pipe with brass cap stamped:

Set pipe 14" in ground with mound of stone to cap.

T2S R33 E
 1
 4
 S31 + S32
 1980
 OR PLS 1294

9

ACCESSORIES: DESCRIBE NEW BT'S WITNESS OBJECTS ETC. ESTABLISHED, OR WORK DONE TO PRESERVE EXISTING EVIDENCE

Trees for BT's and steepness of hillside makes it imprac. to build mounds of stone for Bearing objects, so Bearings were turned to distinguishing land marks.

Bearing Objects:

S78°E a Large Lone Fir on a bald hillside slope to the west at the head of a east-west draw.
 S23°E to a rock point on the skyline of an east-west ridge. Ridge is mostly covered by trees. Rock point sets out in a clearing, bearing shot to highest point.

10

Work Done By R. C. Orton Title Party Chief Date 8-18-80 State Registration No. or Agency _____

Certified Cor. Record Prepared? (Yes) No Filed At: _____ Date _____

11

REMARKS

Witnesses: R. Orton
 G. Wagoner
 G. Lester
 J. Anderson

Index File No. X-5 T. 25 R. 33E M. _____ Tract or Surv. No. _____ Cor. 13
 U.S. G.P.O. 1977-725-576/586

12

Index File No. X-5

CORNER RECORD (SEARCH)

Tract-or Survey No. _____


Cor. No. X-5²

T 2S R. 33E

R.D. Ukiah County Umatilla

Merid. Will.

N.F. Umatilla State Oregon

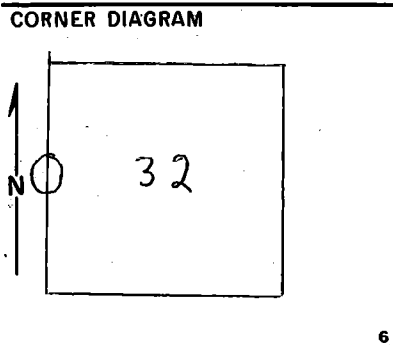

DESCRIBE CORNER MONUMENT FOUND

None

DESCRIBE BEARING TREES OR OTHER OFFICIAL ACCESSORIES FOUND

[Note: No BT's originally scribed]

PHOTO IDENTIFICATION DATA

Photo No. EQO, 8-98 (9-1-66)

Filed At. _____

Object Ident. None

Ident. By Tom Sutherland
Signature

DESCRIBE CORNER LOCATION RELATIVE TO NEAR-BY FEATURES, ALSO HOW TO REACH CORNER

Area of corner on steep, rocky, treeless S-facing hillside.

PLANE COORDINATE POSITION DATA

State _____ Zone _____

X _____

Y _____

Estab. By _____
Agency

Signature: Mike Lilly

Title Eng. Aide Division USFS Headquarters Umatilla-S.O. Date 8-12-69

7100-52 REV. 65 5

CORNER RECORD (PERPETUATION)

MONUMENT : DESCRIBE NEW MONUMENT SET, OR WORK DONE TO PRESERVE EXISTING MONUMENT

ACCESSORIES : DESCRIBE NEW BT'S WITNESS OBJECTS ETC. ESTABLISHED, OR WORK DONE TO PRESERVE EXISTING EVIDENCE

Work Done By MARVIN BENSON Title ENR Aide Date 8/12/69 State Registration No. or Agency U.S. FOREST SERVICE

Certified Cor. Record Prepared ? Yes No Filed At: _____ Date _____

REMARKS

Resurvey notes (1891) states that canyon bottom is 10 ch. N. of corner. By chaining the 13.25 ch from S corner to Sec. 31 and 32, T2S, R33E as stated in resurvey notes, we found ~~the~~ $\frac{1}{4}$ corner to be 6 $\frac{1}{2}$ ch. from corner canyon.

Index File No. X-5 T. 2S R. 33E M. Will. Tract or Surv. No. _____ Cor. X-5