

OREGON CORNER RESTORATION FORM

Section 32 Township 2S Range 33E
 County Umatilla Date: June 3, 2000

Corner Designation: 2S33X9

Common quarter corner to sections 32 and 33, T2S, R33E, W.M., Umatilla County, Oregon.



Condition Report Only
 Not found
 Remonumented
 Unrecorded
 Surveyed in
 Referenced out

Previous Renewals / Surveys, etc.

Corner originally set by John C. Arnold under contract #551 dated March 19, 1890.
 His record reads: Set basalt stone, 18 x 8 x 4 ins., 12 ins. in ground for 1/4 section cor. marked 1/4 on W. face, raised a mound of stone 2 ft. high by 3 1/2 ft. base over stone from which: A pine, 36 ins diam., brs. S45°W, 123 lks dist., marked 1/4 S BT.

Monument and Accessories found: (condition and source)

The original stone, firmly in place, plainly chisled 1/4. The pine BT had been felled during logging and a portion of the scribing was on the stump and a portion was on a section of the tree which had been cut off and left.

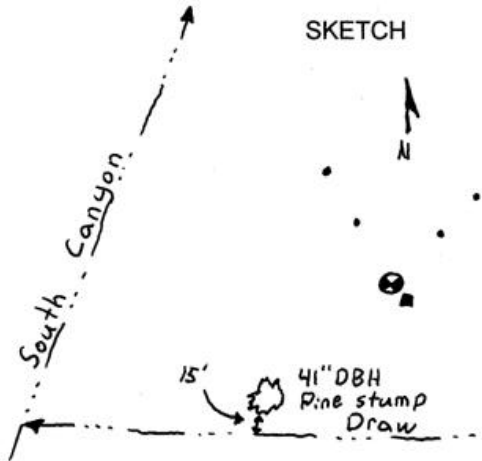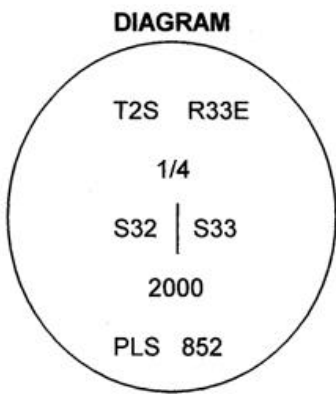

● = Brass cap
 • = Reference
 ■ = Guard post

MONUMENT (S) AND ACCESSORIES SET (Procedures and Description)

Set a 1 1/2" x 30" galvanized iron pipe with a 2 1/4" brass cap stamped as shown in the diagram above at the position of the original stone. Buried the stone along side. Set a 6' steel post with a county monument sign attached along side.

For references, I set four 5/8" by 24" rebars with 1.25" red plastic caps stamped ORLS 852 and WAL5 13922 as described below:

- an iron rebar bears N12°39'43"W, 74.13 feet;
- an iron rebar bears N10°47'41"W, 44.19 feet;
- an iron rebar bears N48°47'26"E, 62.39 feet;
- an iron rebar bears N48°30'57"E, 38.24 feet;

The monument and references were tied using a LIECA system 300 RTK GPS.

Location and comments

Compass Declination

Surveyors Seal

RECEIVED BY:
Umatilla County Surveyor
 Date: 7-20
 Rec'd By: KR
 No. 00-156-C

Firm / Agency
 Haddock Surveying
 Address
 P.O. Box 1574
 Pendleton, Or. 97801
 Party Chief
 Stephen K, Haddock

