

Index  
File No. \_\_\_\_\_

**CORNER RECORD (SEARCH)**

(Ref. FSM 7151.4)

Tract or  
Survey No. UIR

Cor.  
No. 60 1/2 M.P.


T 2 S. R. 34 E.

R.D. \_\_\_\_\_ County UMATILLA

Merid. WILLAMETTE

N.F. UMATILLA State OREGON

CORNER DIAGRAM

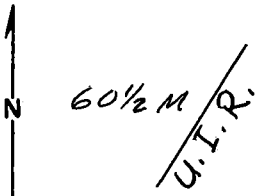

DESCRIBE CORNER MONUMENT FOUND

NONE

DESCRIBE BEARING TREES OR OTHER OFFICIAL ACCESSORIES FOUND

NONE

PHOTO IDENTIFICATION DATA

Photo No. \_\_\_\_\_

Filed At. \_\_\_\_\_

Object Ident. \_\_\_\_\_

Ident. By \_\_\_\_\_

Signature

PLANE COORDINATE POSITION DATA

State \_\_\_\_\_ Zone \_\_\_\_\_

X \_\_\_\_\_

Y \_\_\_\_\_

Estab. By \_\_\_\_\_

Agency

DESCRIBE CORNER LOCATION RELATIVE TO NEAR-BY FEATURES, ALSO HOW TO REACH CORNER

TAKE ROAD 21 TO WEST LINE OF S.31, T.25., R.35 E.,  
TAKE ROAD NORTH, 2.4 MI. ± TO CC  $\frac{24}{25}$ , GO N. 20° E.,  
1745' ± TO 60 1/2 MILE POST ON SOUTH SIDE OF  
CREEK.

Signature

*Clayton J. W...*

Title

LAND SURVEYOR

Division

Headquarters

Date

8-14-85

FS-7100-52 (3/68)

CORNER RECORD (PERPETUATION)

MONUMENT: DESCRIBE NEW MONUMENT SET, OR WORK DONE TO PRESERVE EXISTING MONUMENT

SET A 2 1/2" DIAM. ALUM. CAP IN A 2 1/2" X 30" ALUM. PIPE AT PROPORTIONAL POINT FOR CORNER. RAISED ROCK MOUND. CREEK 5 1/2 NORTH. CAP MKD. PER SKETCH. SET STEEL POSTS W/SIGNS ATTACHED, 4 1/2 SOUTH AND 18 1/2 NORTH.

UIR / T25  
60 1/2 M / R34E  
524  
RPLS 1910  
1985 9

ACCESSORIES : DESCRIBE NEW BT'S WITNESS OBJECTS ETC. ESTABLISHED, OR WORK DONE TO PRESERVE EXISTING EVIDENCE

17" D.B.H. DOUGLAS FIR, NORTH, 27.5', SCRIBED 60 1/2 MUIR BT.  
16" D.B.H. WHITE FIR, 61° W., 4.5', SCRIBED 60 1/2 MUIR BT.  
EACH B.T. HAS A BRASS WASHER MKD. RPLS 1910 SET BTWN. B & T, A B.T. TAG, MON. SIGNS AND BANDS & FACES PAINTED RED.

Work Done By G. J. MARTIN Title LAND SURVEYOR Date 8-14-85 State Registration No. LS 1910  
or Agency

Certified Cor. Record Prepared? Yes  No  Filed At: \_\_\_\_\_ Date \_\_\_\_\_

REMARKS

Index File No. T. 2 S. R. 34 E. M. WILLAMETTE Tract or Surv. No.

Cor. 60 1/2 M / 13

Index

File No. \_\_\_\_\_

CORNER RECORD (SEARCH)

(Ref. FSM 7151.4)

Tract or

Survey No. UIR

Cor.

No. MP 60 1/2


T 25 R. 34E

R.D. Ukiah County Umatilla

Merid. Will

N.F. Umatilla State Oregon

CORNER DIAGRAM

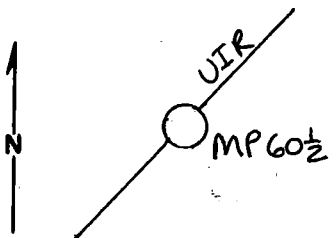

DESCRIBE CORNER MONUMENT FOUND

Searched for but none found.

DESCRIBE BEARING TREES OR OTHER OFFICIAL ACCESSORIES FOUND

Searched for but none found.

PHOTO IDENTIFICATION DATA

Photo No. \_\_\_\_\_

Filed At. \_\_\_\_\_

Object Ident. \_\_\_\_\_

Ident. By \_\_\_\_\_

*Signature*

PLANE COORDINATE POSITION DATA

State \_\_\_\_\_ Zone \_\_\_\_\_

X \_\_\_\_\_

Y \_\_\_\_\_

Estob. By \_\_\_\_\_

*Agency*

Signature

*Dennis L. Gaylord*

Title

Division

Headquarters

Date

*PLS 1636*

*5-24-84*

7100-52 (3/68)

**CORNER RECORD (PERPETUATION)**

**MONUMENT: DESCRIBE NEW MONUMENT SET, OR WORK DONE TO PRESERVE EXISTING MONUMENT**

**ACCESSORIES : DESCRIBE NEW BT'S WITNESS OBJECTS ETC. ESTABLISHED, OR WORK DONE TO PRESERVE EXISTING EVIDENCE**

Work Done By \_\_\_\_\_ Title \_\_\_\_\_ Date \_\_\_\_\_ State Registration No. \_\_\_\_\_  
or Agency \_\_\_\_\_

Certified Cor. Record Prepared ? Yes No Filed At: \_\_\_\_\_ Date \_\_\_\_\_

**REMARKS**

Index File No. T. R. M. Tract or Surv. No. Cor.