

Index  
File No. \_\_\_\_\_

CORNER RECORD (SEARCH)

(Ref. FSM 7151.4)

Tract or Survey No. U. I. R. Cor. No. 60 M.P.

T 2 S. R. 34 E.

R.D. \_\_\_\_\_ County UMATILLA

Merid. WILLAMETTE

N.F. UMATILLA State OREGON

CORNER DIAGRAM



*U.I.R.  
60 M*

DESCRIBE CORNER MONUMENT FOUND

*NOTHING AT POINT FOR CORNER, STONES WERE PROBABLY USED IN FENCE JACKS.*

DESCRIBE BEARING TREES OR OTHER OFFICIAL ACCESSORIES FOUND

*22" D.B.H. PONDEROSA PINE, (24"), S. 21° E, 107 LKS., SCRIBED 60 M UR BT.*

*24" D.B.H. DOUGLAS FIR, (18"), DEAD & DOWN, S. 44° W., 171 LKS., SCRIBED 60 M UR BT.*

PHOTO IDENTIFICATION DATA

Photo No. \_\_\_\_\_

Filed At. \_\_\_\_\_

Object Ident. \_\_\_\_\_

Ident. By \_\_\_\_\_

*Signature*

PLANE COORDINATE POSITION DATA

State \_\_\_\_\_ Zone \_\_\_\_\_

X \_\_\_\_\_

Y \_\_\_\_\_

Estab. By \_\_\_\_\_

*Agency*

DESCRIBE CORNER LOCATION RELATIVE TO NEAR-BY FEATURES, ALSO HOW TO REACH CORNER

*TAKE 2135 050 ROAD TO CABIN, GO NORTHWEST ALONG NORTH SIDE OF DRAW 600' ± TO MILE POST WHICH IS ON A POINT BTWN. 2 DRAWS.*

Signature

Title

Division

Headquarters

Date

FS-7100-52 (3/68)

*Clayton J. M... LAND SURVEYOR*

*7-12-85*

**CORNER RECORD (PERPETUATION)**

**MONUMENT: DESCRIBE NEW MONUMENT SET, OR WORK DONE TO PRESERVE EXISTING MONUMENT**

SET A 2 1/2" DIAM. ALUM. CAP IN A 2 1/2" X 30" ALUM. PIPE AT CORNER,  
 AT RECORD DISTANCE FROM B.T.'S. CAP MKD. PER SKETCH. RAISED  
 STONE MOUND 7' X 5' X 2'. SET STEEL POSTS 2' ± N. & S. W/  
 ATTN. & MON. SIGNS ATTACHED.

UIR / T25  
 60M / R34E  
 524  
 RPLS 1910  
 1985

**ACCESSORIES: DESCRIBE NEW B.T.'S WITNESS OBJECTS ETC. ESTABLISHED, OR WORK DONE TO PRESERVE EXISTING EVIDENCE**

8" D.B.H. DOUGLAS FIR, N. 80 1/2" W., 119.8'; SCRIBED 60 M UIR BT, SET A BRASS WASHER  
 MKD. RPLS 1910 BTWN B&T.  
 ALL B.T.'S. HAVE B.T. TAGS, ATTN. SIGNS AND FACES & BANDS PAINTED RED.

Work Done By G.J. MARTIN Title LAND SURVEYOR Date 7-12-85 State Registration No. LS 1910  
 or Agency

Certified Cor. Record Prepared? Yes  (No) Filed At: \_\_\_\_\_ Date \_\_\_\_\_

REMARKS

Index File No. T. 2 S. R. 34 E. M. WILLAMETTE Tract or Surv. No. \_\_\_\_\_ Cor. UIR / 60M


Index  
File No. \_\_\_\_\_  
T S R. 34E  
Merid. Will

CORNER RECORD (SEARCH)  
(Ref. FSM 7151.4)

Tract or Survey No. UIR Cor. No. MP 60

R.D. Okiah County Umatilla  
N.F. Umatilla State Oregon

CORNER DIAGRAM

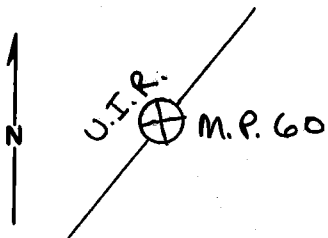

DESCRIBE CORNER MONUMENT FOUND

Found mound of ~~stone~~ in fence line but none are visibly marked.

DESCRIBE BEARING TREES OR OTHER OFFICIAL ACCESSORIES FOUND

Orig. 24" pine is alive with scribes visible on double blazes and bears  $S 21^{\circ} E$ , 71 ft from corner.

Orig. 15" fir is down with scribes visible and bears  $S 49^{\circ} W$ , 113 ft from corner.

PHOTO IDENTIFICATION DATA

Photo No. \_\_\_\_\_  
Filed At. \_\_\_\_\_  
Object Ident. \_\_\_\_\_  
Ident. By \_\_\_\_\_  
*Signature*

PLANE COORDINATE POSITION DATA

State \_\_\_\_\_ Zone \_\_\_\_\_  
X \_\_\_\_\_  
Y \_\_\_\_\_  
Estab. By \_\_\_\_\_  
*Agency*

DESCRIBE CORNER LOCATION RELATIVE TO NEAR-BY FEATURES, ALSO HOW TO REACH CORNER

Signature

Title

Division

Headquarters

Date

7100-52-(3, 68)

*Dennis L. Gaylord*

PLS

1636

6-14-84

**CORNER RECORD (PERPETUATION)**

**MONUMENT: DESCRIBE NEW MONUMENT SET, OR WORK DONE TO PRESERVE EXISTING MONUMENT**

**ACCESSORIES : DESCRIBE NEW BT'S WITNESS OBJECTS ETC. ESTABLISHED, OR WORK DONE TO PRESERVE EXISTING EVIDENCE**

Work Done By \_\_\_\_\_ Title \_\_\_\_\_ Date \_\_\_\_\_ State Registration No. \_\_\_\_\_  
or Agency \_\_\_\_\_

Certified Cor. Record Prepared ? Yes No Filed At: \_\_\_\_\_ Date \_\_\_\_\_

**REMARKS**

Index File No. T. R. M. Tract or Surv. No. Cor.