

Form 874-9—Revised May, 1918

U. S. Department of Agriculture
FOREST SERVICE

Unadilla NATIONAL FOREST

CORNERS OF THE PUBLIC SURVEY

T. 2 S R. 35 E W Mer.

Section Corner common to Sections
3, 4, 9, and 10

Corner consists of a Corner stone (not) in place
State condition no stone not found

Dimensions above ground _____ inches
Sketch grooves, letters, figures, or notches, on proper face or edge.

N	W	S	E

NW	SW	SE	NE

Mound of _____ is located _____

Pits are located _____

Sketch markings of Bearing Trees (or Rocks) in proper box and fill blanks below, giving bearings from Corner to Trees and Distances in Links.

<u>25</u> <u>35 E</u> <u>34</u>		<u>S 10</u>	<u>T 2 S</u> <u>R 35 E</u> <u>S 3</u>
<u>BT</u>		<u>BT</u>	<u>BT</u>

Species YP YP YP

Diameter 32 36 28

Bearing Trees stand in a triangle shape

Distance not over 30 ft apart

Do you believe this to be a genuine Land Office Corner? _____

If not, why? Corner could not be


found but is inside 30 ft. triangle
of witness trees.

Aug 8/17
(Date)

L. J. Surber
(Signature)
Dist Ranger
(Title)

T. 2 S R. 35 E W Mer.

(Make sketch of topography near Corner)

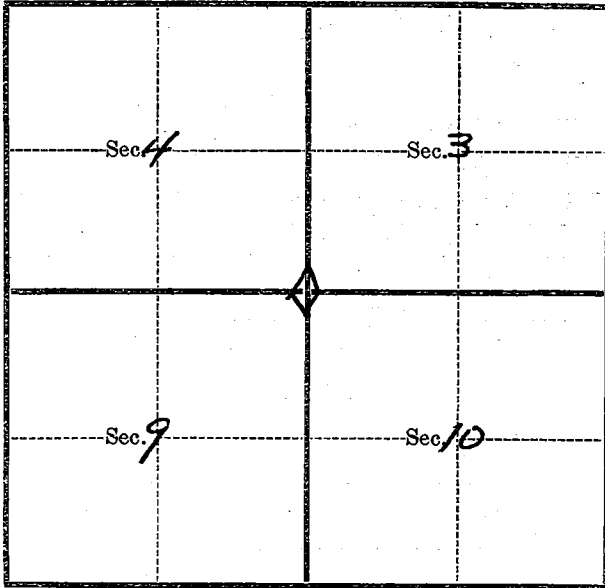

Metal Location Poster is on a No poster put up.
tree inches diameter, on the
side of
from which this Corner bears
..... chains distant.

Give any further facts which will aid in finding this
Corner again.

Corner located on aerial photo
Parallel District Copy.

USDA-FOREST SERVICE

Index
File No. E-13

T 25 R. 35E

CORNER RECORD (SEARCH)

(Ref. FSM 7151.4)


Tract or
Survey No.

Cor.
No.

R.D. UKIAH County Uma Killa/Umbar

N.F. Uma Killa State Ore.

CORNER DIAGRAM

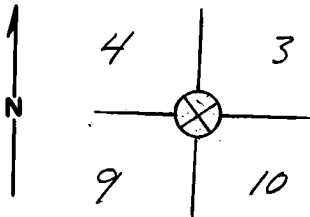

DESCRIBE CORNER MONUMENT FOUND

BASALT STONE MISSING

SEC. COR.

DESCRIBE BEARING TREES OR OTHER OFFICIAL ACCESSORIES FOUND

PIR MARKED T2S, R35E, S10BT MISSING

PIR MARKED T2S, R35E S9BT EXISTING

PINE " " " S4BT EXISTING

PINE " " " S3BT EXISTING

EXISTING B.T.s STANDING & IN good condition

DESCRIBE CORNER LOCATION RELATIVE TO NEAR-BY FEATURES, ALSO HOW TO REACH CORNER

STEEP side slope - FENCE RUNS N-S ALONG APPARENT SEC. Line.

Animals probably rolled ROCK into draw below SEC. Cor. location

PHOTO IDENTIFICATION DATA

Photo No. _____

Filed At. _____

Object Ident. _____

Ident. By _____

Signature

PLANE COORDINATE POSITION DATA

State _____ Zone _____

X _____

Y _____

Estab. By _____

Agency

Signature

L Kelly

Title

Division

Headquarters

SO

Date

8-83

7100-52-(3,68)

CORNER RECORD (PERPETUATION)

MONUMENT : DESCRIBE NEW MONUMENT SET, OR WORK DONE TO PRESERVE EXISTING MONUMENT

ACCESSORIES : DESCRIBE NEW BT's WITNESS OBJECTS ETC. ESTABLISHED, OR WORK DONE TO PRESERVE EXISTING EVIDENCE

Work Done By _____ **Title** _____ **Date** _____ **State Registration No. or Agency** _____

Certified Cor. Record Prepared ? Yes No **Filed At:** _____ **Date** _____

REMARKS

Index File No. _____ **T.** _____ **R.** _____ **M.** _____ **Tract or Surv. No.** _____ **Cor.** _____