

**CERTIFIED RECORD OF LAND CORNER MONUMENTATION**

**HISTORY OF ORIGINAL CORNER ESTABLISHED:**


Original corner set by L.E. Wilkes under GLO special instructions dated February 20, 1917, included under Group No. 29. Field notes state:

Set an iron post, 3 ft. long, 1 ins. diam., 24 ins. in the ground, for closing cor. of secs. 7 and 18, with brass cap marked, from which:

A fir, 8 ins. diam., bears S.7°E., 23 lks. dist. marked CC T2S R35E S18 BT.

A pine, 16 ins. diam., bears N.89°E., 46 lks. dist. marked CC T2S R35E S7 BT.

T 2 S R 35 E J-02.5

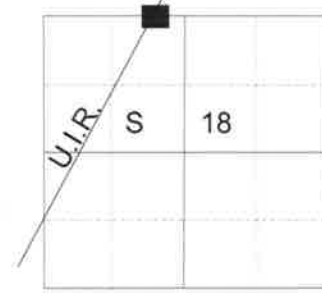

**DESCRIPTION OF CORNER EVIDENCE FOUND:**

Found 2 1/2" iron pipe with 2 1/2" GLO Brass Cap marked as shown below, protruding 15" above ground, from which:

A 38" Ponderosa Pine bears North 80° East, a distance of 30.4 ft. dist., alive and vigorous with healed blaze.

SEE SURVEY FOR HANCOCK FOREST MANAGEMENT DATED OCTOBER 2017

**DESCRIPTION OF MONUMENT AND ACCESSORIES I ESTABLISHED**

**TO PERPETUATE THE ORIGINAL LOCATION OF THIS CORNER:**

From the iron pipe monument,

**NEW BEARING TREES:**

A 7" Douglas Fir bears North 38° East, a distance of 20.25 feet, marked CC T2S R35E S7 BT.


A 5" Ponderosa Pine bears South 32° East, a distance of 13.80 feet, marked CC T2S R35E S18 BT.

I hereby certify that the corner was perpetuated October 26, 2017.

Witness: Kyle Tucker



Renewal Date: June 30, 2019

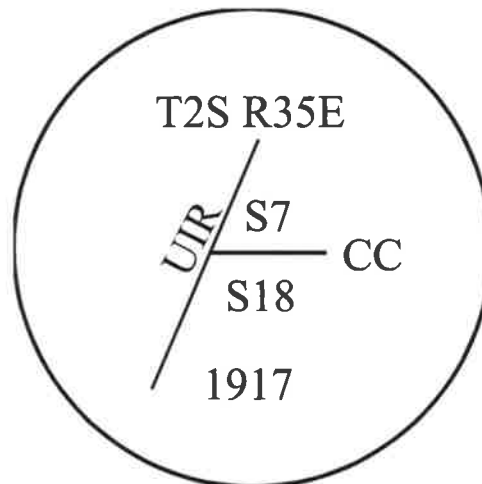

I used a steel tape and magnetic compass in the establishment of the bearing trees. Magnetic declination used was 13° East. Bearing is to a brass washer marked OPLS 83571 in the lower blaze of the tree. Distance is to a spike set in the root crown of the side of the tree.