

CERTIFIED RECORD OF LAND CORNER MONUMENTATION

HISTORY OF ORIGINAL CORNER ESTABLISHED:

Original corner set by Rufus Moore, under GLO contract No. 451, dated June 12, 1882. Surveyor General Record States:

Set a post 3 ft. long, 3 ins. square, 24 ins. in the ground for 1/4 se. cor. 200 ft. below sec. cor. marked 1/4 S on W face, from which:

A pine, 12 ins. in dia. bears N57°W, 8 lks. dist. marked 1/4 SBT.

A pine, 14 ins. in dia. bears S21°W, 30 lks. dist. marked 1/4 SBT.


Corner recovered and replaced by L.E. Wilkes under GLO special instructions dated February 20, 1917, included under Group No. 29. Field notes state:

Set an iron post, 3 ft. long, 1 ins. diam., 26 ins. in the ground, for 1/4 sec. cor., with brass cap. From which:

A pine, 12 ins. diam., bears N.52°W., 8 lks. dist. marked 1/4 S7 BT (Old BT)

A fir, 15 ins. diam., bears S.23°W., 30 lks. dist. marked 1/4 S18 BT (Old BT)

T 2 S R 35 E J-03

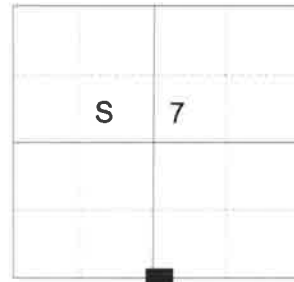

DESCRIPTION OF CORNER EVIDENCE FOUND:

Found 1" iron pipe with 2 1/2" Brass Cap marked as shown below, from which:

A 14" tree, dead and downed, the stump hole which bears South 23° West, a distance of 19.8 feet, with scribes visible on open blaze.

DESCRIPTION OF MONUMENT AND ACCESSORIES I ESTABLISHED TO PERPETUATE THE ORIGINAL LOCATION OF THIS CORNER:

From the iron pipe monument,

NEW BEARING TREES:

A 4" Douglas Fir bears North 35° East, a distance of 11.75 feet, marked X BT.

A 16" Douglas Fir bears South 70° East, a distance of 51.00 feet, marked 1/4 S18 BT.

A 9" Douglas Fir bears South 65° West, a distance of 27.90 feet, marked 1/4 S18 BT.


A 17" Ponderosa Pine bears North 64° West, a distance of 38.25 feet, marked 1/4 S7 BT.

I hereby certify that the corner was perpetuated October 25, 2017.

Witness: Kyle Tucker



Renewal Date: June 30, 2019

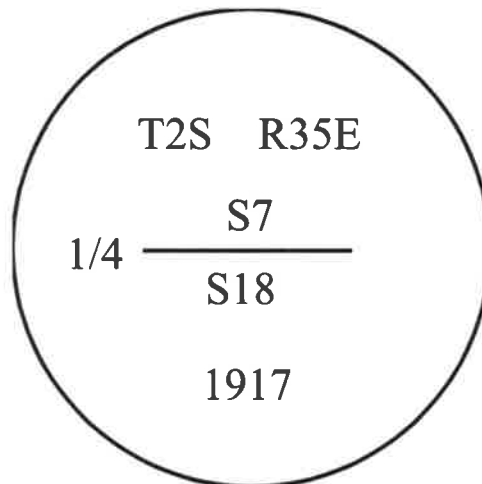

I used a steel tape and magnetic compass in the establishment of the bearing trees. Magnetic declination used was 13° East. Bearing is to a brass washer marked OPLS 83571 in the lower blaze of the tree. Distance is to a spike set in the root crown of the side of the tree.