

USDA-FOREST SERVICE

Index File No. J-5

T 25 R. 35E

Merid. _____

CORNER RECORD (SEARCH)

(Ref. FSM 7151.4)

R.D. UKIAH

County Umatilla

N.F. Umatilla

State Ore


Tract or

Survey No. _____

Cor.

No. _____

CORNER DIAGRAM

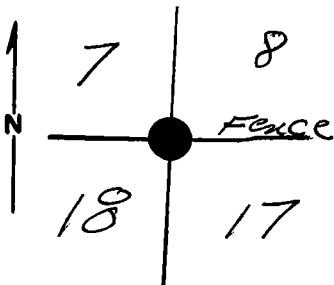

DESCRIBE CORNER MONUMENT FOUND

Brass Cap - GLO. 1917

DESCRIBE BEARING TREES OR OTHER OFFICIAL ACCESSORIES FOUND

Tam - 20" Dead S 18

Tam - 24" Dead S 17

PHOTO IDENTIFICATION DATA

Photo No. _____

Filed At. _____

Object Ident. _____

Ident. By _____

Signature

PLANE COORDINATE POSITION DATA

State _____ Zone _____

X _____

Y _____

Estab. By _____

Agency

DESCRIBE CORNER LOCATION RELATIVE TO NEAR-BY FEATURES, ALSO HOW TO REACH CORNER

Flat topog - second growth fir
465' E of Spur Road

Signature

L. Kelly D. Gaylord

Title

Division

Headquarters

50

Date

8-03

7100-52 (3-68)

CORNER RECORD (PERPETUATION)

MONUMENT: DESCRIBE NEW MONUMENT SET, OR WORK DONE TO PRESERVE EXISTING MONUMENT

9

ACCESSORIES : DESCRIBE NEW BT'S WITNESS OBJECTS ETC. ESTABLISHED, OR WORK DONE TO PRESERVE EXISTING EVIDENCE

10

Work Done By _____ Title _____ Date _____ State Registration No. or Agency _____

Certified Cor. Record Prepared ? Yes No Filed At _____ Date _____

11

REMARKS

12

Index File No. T. R. M. Tract or Surv. No. Cor.

13