


CERTIFIED RECORD OF LAND CORNER MONUMENTATION

HISTORY OF ORIGINAL CORNER ESTABLISHED:

Original not previously established.

T 2 S R 35 E K-03

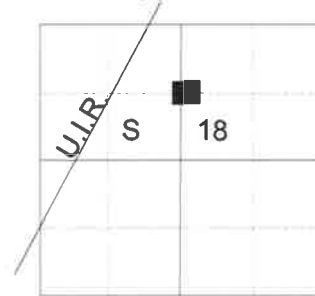

DESCRIPTION OF CORNER EVIDENCE FOUND:

None.

SEE SURVEY FOR HANCOCK FOREST MANAGEMENT DATED OCTOBER 2017

DESCRIPTION OF MONUMENT AND ACCESSORIES I ESTABLISHED

TO PERPETUATE THE ORIGINAL LOCATION OF THIS CORNER:

At position determined by survey, I set a 5/8"x30" iron pin rebar, with 2 1/2" aluminum cap, marked as shown below, 27" in the ground, in a collar of stone 1 ft. diam., from which:

NEW BEARING TREES:


An 8" Douglas Fir bears South 50° East, a distance of 13.15 feet, marked CN 1/16 S18 BT.
A 5" Ponderosa Pine bears South 87° East, a distance of 7.80 feet, marked X BT.

I hereby certify that the corner was monumented October 26, 2017.

Witness: Kyle Tucker



Renewal Date: June 30, 2019

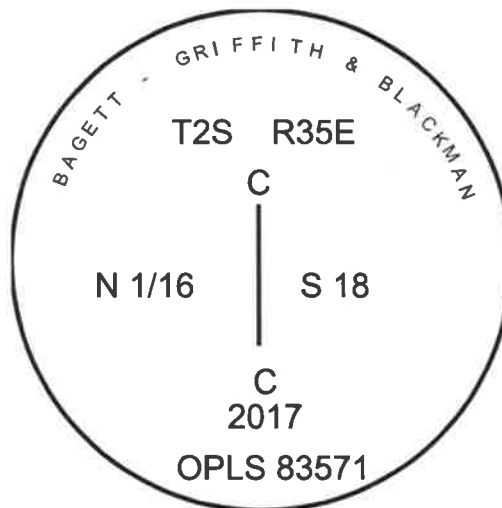

I used a steel tape and magnetic compass in the establishment of the bearing trees. Magnetic declination used was 13° East. Bearing is to a brass washer marked OPLS 83571 in the lower blaze of the tree. Distance is to a spike set in the root crown of the side of the tree.

K-03

17-122-B