

USDA-FOREST SERVICE

Index  
File No. L-1

CORNER RECORD (SEARCH)

(Ref. FSM 7151.4)

Tract or Survey No. \_\_\_\_\_  
Cor. No. \_\_\_\_\_


T 25 R. 35E

R.D. UKIAH County Yuma Co

Merid. \_\_\_\_\_

N.F. Umatilla State Ore

CORNER DIAGRAM

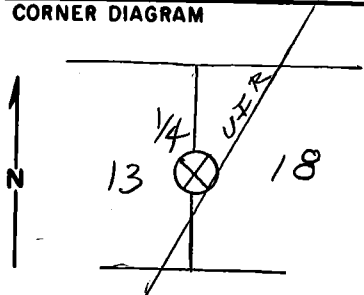

DESCRIBE CORNER MONUMENT FOUND

No Corner monument found 1/4

DESCRIBE BEARING TREES OR OTHER OFFICIAL ACCESSORIES FOUND

FIR BT. 16"  
1 Pilot Rock Lumber Co K-Cord.  
1 old USFS K-Cord

PHOTO IDENTIFICATION DATA

Photo No. \_\_\_\_\_  
Filed At. \_\_\_\_\_  
Object Ident. \_\_\_\_\_  
Ident. By \_\_\_\_\_  
*Signature*

DESCRIBE CORNER LOCATION RELATIVE TO NEAR-BY FEATURES, ALSO HOW TO REACH CORNER

on U.I.R.  
Approx 15' N Johnson Road  
7 Lat ground Second growth Timber  
Logged over

PLANE COORDINATE POSITION DATA

State \_\_\_\_\_ Zone \_\_\_\_\_  
X \_\_\_\_\_  
Y \_\_\_\_\_  
Estab. By \_\_\_\_\_  
*Agency*

*Signature*  
L Kelly

Title \_\_\_\_\_ Division \_\_\_\_\_ Headquarters SO

Date Jan 85 7100-52-(3,68)

**CORNER RECORD (PERPETUATION)**

**MONUMENT: DESCRIBE NEW MONUMENT SET, OR WORK DONE TO PRESERVE EXISTING MONUMENT**

**ACCESSORIES: DESCRIBE NEW BT'S WITNESS OBJECTS ETC. ESTABLISHED, OR WORK DONE TO PRESERVE EXISTING EVIDENCE**

Work Done By \_\_\_\_\_ Title \_\_\_\_\_ Date \_\_\_\_\_ State Registration No. \_\_\_\_\_  
or Agency \_\_\_\_\_ 10

Certified Cor. Record Prepared? Yes No Filed At: \_\_\_\_\_ Date \_\_\_\_\_ 11

**REMARKS**

Index File No. T. R. M. Tract or Surv. No. Cor. 12  
13